

LEFLORE  
L 76  
10-3-74

MISSISSIPPI  
BOARD OF WATER COMMISSIONERS  
416 North State Street  
Jackson, Mississippi 39201

CODED

WATER WELL DRILLERS LOG

Oct. 3, 1974 Bruce Berryman - Leflore  
date well completed Greenwood, Miss county well located

LANDOWNER: Tony Joe  
Hwy 82E, Greenwood,  
Miss. 38930  
(mailing address)

WELL LOCATION:  
sec. 13 T 19 N R 1 E  
S W  
3 miles East of Greenwood  
(distance) (direction) (nearest town)

WELL PURPOSE: Home  
(home, irrigation, municipal, industrial)

WELL COMPLETION DATA:  
(1) diameter (inches) 4" x 2"  
(2) total depth (feet) 641  
(3) static water level (feet)            <sup>below</sup> above top of ground  
(4) casing 2" gal blk pipe - 115'  
(material) (depth) 515'  
           (size) If telescope see back.  
(5) screen 10' 631'  
(length) (depth to top)  
2" .010 Stainless steel  
(size) (material)  
(6) pump NO  
(HP) (yield gpm)  
           (type power)  
(7) electric log NO  
(yes or no)  
           (organization running log)  
(8) how well bottom plugged B.P.V

description of fomations encountered	from	to
Clay	0	20
Sand	20	120
Clay	120	200
Sandy shale	200	220
Green Sand	220	240
Sandy shale	240	320
Sand	320	340
Clay	340	360
Sandy shale	360	380
Clay	380	450
Sand str. shale	450	530
Green sand	530	560
Clay	560	600
White sand	600	650
Clay	650	660

CODED


RECEIVED

FEB 13 1975

DRILLERS REMARKS:

If well telescopes please sketch and show depths.

GROUND LEVEL

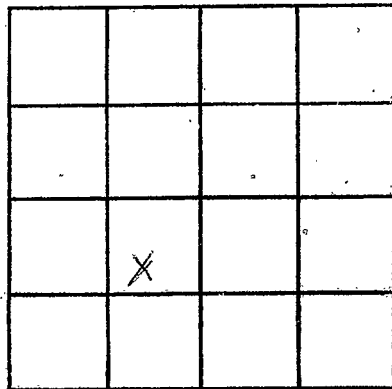

SECTION 13

Please indicate well location X.

ADDITIONAL INFORMATION

If more than one screen,  
show locations of each on sketch.