

LeFlore
L 81
12-66

MISSISSIPPI BOARD OF WATER COMMISSIONERS

WATER WELL DRILLERS LOG

CODED

Date: DEC 29, 1966, Driller: DELTA DRILLING Co. County LEFLORE

(Name)

(1) Owner of Land: E.L. FONDREN
(Name)

ITTA BENA - MISS -
(Address)

(2) Location: SW 1/4, NW 1/4, Sec. 18 T. 19 N. R. 25 E

2 miles EAST, of GREENWOOD
(distance) (direction) (Nearest Town)

(3) Topography: FLAT
(Hilly) (Flat) (Level)

(4) Purpose of Well: DOMESTIC
(Domestic Irrigation, Municipal, Industrial, Other)

Description & Color of Materials Sand, Clay, Red Clay, Shell, etc.	Thick- ness Feet	Depth Feet
gumbo	45	45
gravel	52	97
sand	61	158
gumbo	21	179
sand w/rocks	83	262
shale	41	303
sand	30	333
shale CODED	30	363
sand w/rock	52	415
shale	50	465
sand	83	548

Information upon completion of well:

(1) Diameter 4 inches.

(2) Total Depth 544 feet.

(3) Water Level FLOWS feet below top of ground.

(4) Cased to 519, Size 4" 75 2" 494


(5) Screen: Size 2", Length 25'

(6) Were any formations sealed against pollution?
 yes, no.

If YES depth of formation 75'

Why _____

Drillers Remarks: _____

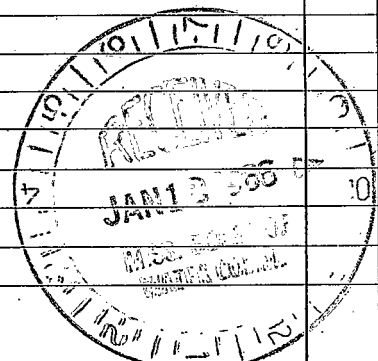

(Use Back Side)

Well No.

