

*Leflore*  
 L 84  
 7-67

MISSISSIPPI  
 BOARD OF WATER COMMISSIONERS  
 416 North State Street  
 Jackson, Mississippi 39201

**CODED**

WATER WELL DRILLERS LOG

July 17, 1967 *Betane Gas of Greenwood* *Leflore*  
 date well completed firm name county well located

LANDOWNER:

VAN D CASEY - GRENADA BLVD

GREENWOOD MISS  
 (mailing address)

WELL LOCATION:

sec. 1 T 19 N R 1 E  
 1 miles N.E of GREENWOOD  
 (distance) (direction) (nearest town)

WELL PURPOSE: Home  
 (home, irrigation, municipal, industrial)

WELL COMPLETION DATA:


- (1) diameter (inches) 2"
- (2) total depth (feet) 419'
- (3) static water level (feet) 2' <sup>below</sup> above top of ground.
- (4) casing Galv. 399' (material) (depth)  
 2" (size) if telescope see back.
- (5) screen 20' 399' (length) (depth to top)  
 2" (size) STAINLESS STEEL (material)
- (6) pump CUSTOMER INSTALLED (HP) (yield gpm)  
 (type power)
- (7) electric log No (yes or no)  
 (organization running log)
- (8) how well bottom plugged  
 BACK PRESSURE VALVE

description of formations encountered

from to

Clay	0	55
Sand & Gravel	55	120
SAND & Shale Strata	120	160
Clay	160	395
White Sand	395	420
Clay	420	430


**CODED**

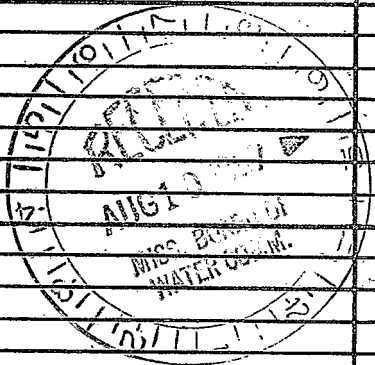

DRILLERS REMARKS:

If well telescopes please sketch and show depths.

GROUND LEVEL

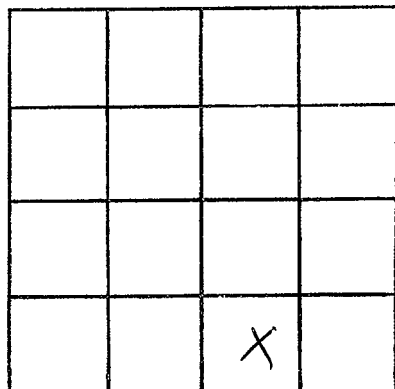

SECTION 1

Please indicate well location X.

ADDITIONAL INFORMATION

If more than one screen, show locations of each on sketch.