

Lefflore
 L 86
 8-67

MISSISSIPPI
 BOARD OF WATER COMMISSIONERS
 416 North State Street
 Jackson, Mississippi 39201

CODED

WATER WELL DRILLERS LOG

Aug 11, 67 19 Butane Gas of Greenwood Lefflore
 date well completed firm name county well located

LANDOWNER: JAMES HARGRAVE
Greenwood, Miss
 (mailing address)


WELL LOCATION:
 sec. 1 T. 19 N. R. 1 E
 S W
1 1/2 miles NE of Greenwood
 (distance) (direction) (nearest town)

WELL PURPOSE: Home
 (home, irrigation, municipal, industrial)

- WELL COMPLETION DATA:
- (1) diameter (inches) 2
- (2) total depth (feet) 419
- (3) static water level (feet) 2' ^{below} top of ground.
- (4) casing Cabl. 399'
 (material) (depth)
2" if telescope see back.
 (size)
- (5) screen 20' 399
 (length) (depth to top)
2" STAINLESS
 (size) (material)
- (6) pump 1/3 56 gpm
 (HP) (yield gpm)
Elect
 (type power)
- (7) electric log No
 (yes or no)
 (organization running log)
- (8) how well bottom plugged
Back Pressure Valve

description of formations encountered	from	to
Clay	1	38
Sand & Gravel	38	170
Clay	170	212
Sand & Shale streaks	212	290
Green Sand	290	330
Shale	330	390
White Sand	390	419


CODED

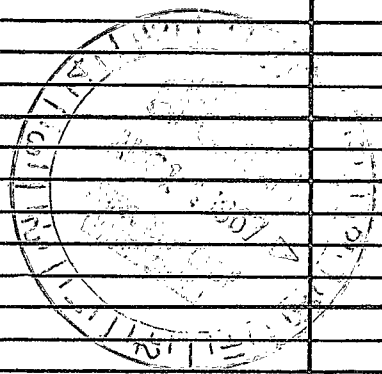

DRILLERS REMARKS:

If well telescopes please sketch and show depths.

GROUND LEVEL

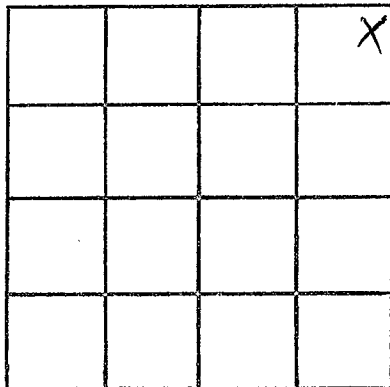

SECTION 1

Please indicate well location X.

ADDITIONAL INFORMATION

If more than one screen, show locations of each on sketch.