

Leflore
 L 93
 10-67

MISSISSIPPI
 BOARD OF WATER COMMISSIONERS
 416 North State Street
 Jackson, Mississippi 39201

WATER WELL DRILLERS LOG

CODED

~~933~~ 10-23 19 67 Dyer Well & Irr. Ser. Leflore
 date well completed firm name county well located

LANDOWNER: D. D. McLaurin

R. R. Greenwood, -

Mississippi

(mailing address)

WELL LOCATION:

sec 17 T 19 N R 2 E
 3 miles E of G-wood
 (distance) (direction) (nearest town)


WELL PURPOSE: Home
 (home, irrigation, municipal, industrial)

WELL COMPLETION DATA:

- (1) diameter (inches) 2"
- (2) total depth (feet) 511 Ft.
- (3) static water level (feet) Flowed below top of ground.
- (4) casing 2" Galv. 531 Ft.
 (material) (depth)
 - If telescope see back.
 (size)
- (5) screen 10Ft. 531 Ft.
 (length) (depth to top)
 2" Stainless Steel
 (size) (material)
- (6) pump none 12GPM
 (HP) (yield gpm)
 None
 (type power)
- (7) electric log No
 (yes or no)
 (organization running log)
- (8) how well bottom plugged Valve

description of fomations encountered	from	to
Clay	0	28
Sand	28	120
Clay	120	179
Rock	179	180
Sand Clay Streaks	180	237
Rock	237	239
Sandy shale	239	308
Rock	308	310
Sandy shale	310	455
Clay	455	502
Sandy Streaks	502	515
Hard Sand	515	550


CODED

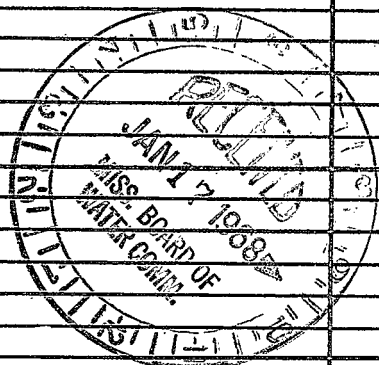

DRILLERS REMARKS:

If well telescopes please sketch and show depths.

GROUND LEVEL

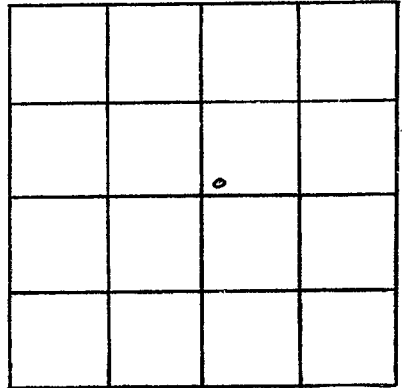

SECTION 17

Please indicate well location X.

ADDITIONAL INFORMATION

If more than one screen, show locations of each on sketch.