

Leflore  
 L94  
 5-68

MISSISSIPPI  
 BOARD OF WATER COMMISSIONERS  
 416 North State Street  
 Jackson, Mississippi 39201

CODED

WATER WELL DRILLERS LOG

5-21-19 68 DYER Well & Irr. LEFLORE  
 date well completed firm name county well located

LANDOWNER:  
Knights of Columbus  
Greenwood, Miss.  
 (mailing address)

description of formations encountered	from	to
CLAY	0	5
SAND	5	62
SAND & GRAVEL	62	135
SAND	135	308
CLAY	308	337
SHALE & ROCC STREAKS	337	375
GREEN SAND	375	423
CLAY & SHALE STREAKS	423	428
SAND	428	450
CLAY	450	462
ROCC	462	463
SAND	463	480
GREEN SAND ROCC ST.	480	505
SANDY SHALE	505	623
Gummy SHALE	623	685
SAND & CLAY STREAKS	685	839
SAND	839	885
CLAY	885	900

WELL LOCATION:  
 sec 28 T 19 N R 1 E  
 (distance) miles of (direction) of (nearest town)

WELL PURPOSE: DOMESTIC  
 (home, irrigation, municipal, industrial)

WELL COMPLETION DATA:  
 (1) diameter (inches) 4" x 2"  
 (2) total depth (feet) 991  
 (3) static water level (feet) 0 below above top of ground.  
4" BLK IR. 2" GALV.  
 (4) casing 861' (material) (depth)  
 (size) if telescope see back.  
 (5) screen 20 FT, 861 FT (length) (depth to top)  
2" STAINLESS STEEL (size) (material)  
 (6) pump 1 1/2 28 (HP) (yield gpm)  
ELEC. (type power)  
 (7) electric log No. (yes or no)  
 (organization running log)  
 (8) how well bottom plugged WAS

[Signature]  
 881


JUN 11 1968  
 MISSISSIPPI BOARD OF WATER COMMISSIONERS

DRILLERS REMARKS:

If well telescopes please sketch and show depths.

GROUND LEVEL

4"x2"  
SWEDGES

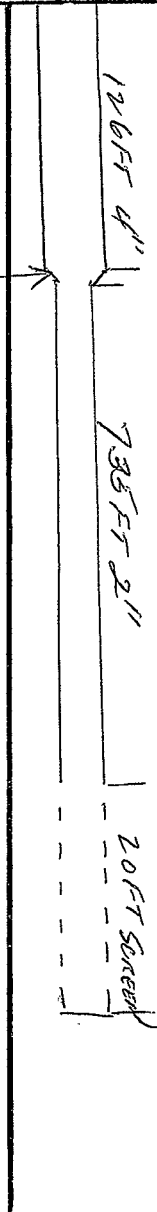

X			

SECTION 28

Please indicate well location X.

ADDITIONAL INFORMATION

If more than one screen, show locations of each on sketch.