

Lefflore
L 96
7-68

MISSISSIPPI
 BOARD OF WATER COMMISSIONERS
 416 North State Street
 Jackson, Mississippi 39201
 WATER WELL DRILLERS LOG


CODED

7-13-68 date well completed Butane Gas Co. of Greenwood firm name Lefflore county well located

LANDOWNER: W.E. TAYLOR
Greenwood, Miss.
 (mailing address)
 WELL LOCATION:
 sec. 17 T. 19 N. R. 2 E. 8
3 miles E of Greenwood
 (distance) (direction) (nearest town)
 WELL PURPOSE: Home
 (home, irrigation, municipal, industrial)

| description of formations encountered | from | to |
|---------------------------------------|------|-----|
| Clay | 0 | 14 |
| Fine Sand | 14 | 23 |
| SAND | 23 | 68 |
| SAND + GRAVEL | 68 | 120 |
| SHALE + ROCK | 120 | 470 |
| SAND | 470 | 495 |
| SHALE | 495 | 501 |
| SAND | 501 | 525 |
| SHALE | 525 | 548 |
| SAND | 548 | 590 |
| SHALE | 590 | 619 |

WELL COMPLETION DATA:
 (1) diameter (inches) 4 3/4
 (2) total depth (feet) 587
 (3) static water level (feet) 20 ^{below} above top of ground.
 (4) casing Steel, 567,
 (material) (depth)
482 if telescope see back.
 (size)
 (5) screen 20', 567
 (length) (depth to top)
2", Stainless Steel
 (size) (material)
 (6) pump 1 20
 (HP) (yield gpm)
Elec.
 (type power)
 (7) electric log No
 (yes or no)
 (organization running log)
 (8) how well bottom plugged
BACK PRESSURE VALVE

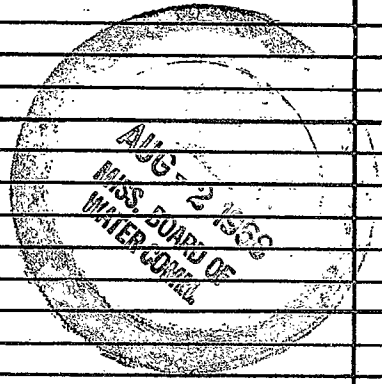

DRILLERS REMARKS:
wfb.

If well telescopes please sketch and show depths.

GROUND LEVEL

105' - 4"
GALV. CASING

462' - 2"
GALV. CASING

20' - 2"
STAINLESS
STEEL SCREEN

| | | | |
|--|--|--|--|
| | | | |
| | | | |
| | | | |
| | | | |

SECTION _____

Please indicate well location X.

ADDITIONAL INFORMATION

If more than one screen,
show locations of each on sketch.