

MISSISSIPPI
BOARD OF WATER COMMISSIONERS
416 North State Street
Jackson, Mississippi 39201

CODED

WATER WELL DRILLERS LOG

Le flare
L97
8-30-68

8-30-68 date well completed Buttine Gas Co. of Greenwood firm name Le flare county well located

LANDOWNER:
Estate of Clint Petreot
Greenwood Miss.
(mailing address)

WELL LOCATION:
sec 8 T 19 N R 2 E
3 miles E of Greenwood
(distance) (direction) (nearest town)

WELL PURPOSE: Home
(home, irrigation, municipal, industrial)


WELL COMPLETION DATA:

- (1) diameter (inches) 2"
- (2) total depth (feet) 545
- (3) static water level (feet) 10 ^{below} top of ground.
- (4) casing Steel 525
(material) (depth)
2 If telescope see back.
(size)
- (5) screen 20 525
(length) (depth to top)
2 Stainless Steel
(size) (material)
- (6) pump 1 30
(HP) (yield gpm)
Elec
(type power)
- (7) electric log no
(yes or no)

(organization running log)
- (8) how well bottom plugged Back
PRESSURE GAUGE

description of formations encountered	from	to
Clay	0	23
SAND	23	61
Sand + Gravel	61	118
Clay	118	163
SHALE + Rock	163	187
SHALE + SAND	187	235
SHALE	235	250
Rock	250	251
SHALE + SAND	251	290
Rock	290	291
SHALE + SAND	291	504
HARD Packed SAND	504	570
SHALE	570	598


CODED

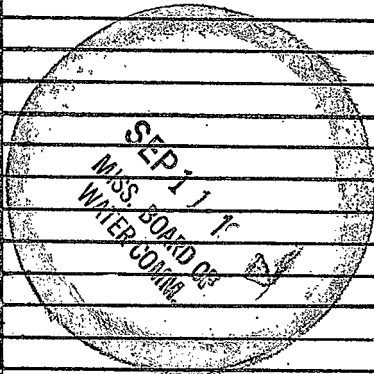

DRILLERS REMARKS: WG

If well telescopes please sketch and show depths.

GROUND LEVEL

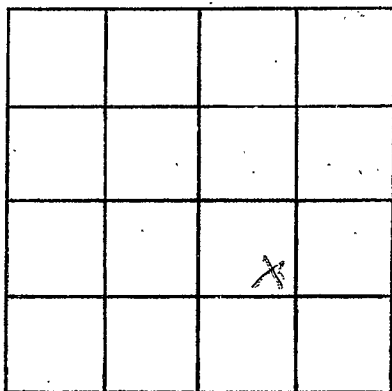

SECTION 8

Please indicate well location X.

ADDITIONAL INFORMATION

If more than one screen, show locations of each on sketch.