

Leflore

MISSISSIPPI BOARD OF WATER COMMISSIONERS

L 98

11-28-61


WATER WELL DRILLERS LOG

CODED 98

Date: NOV. 28, 1961, Driller: DELTA DRILLING Co., County: LEFLORE

(Name)

(1) Owner of Land: <u>GREENWOOD FROZEN FOOD DEPOSITORY</u> (Name)	Description & Color of Materials Sand, Clay, Red Clay, Shell, etc.	Thick-ness Feet	Depth Feet
<u>GREENWOOD, MISS.</u> (Address)	<u>TOP SOIL & SAND</u>	<u>74</u>	<u>74</u>
(2) Location: <u>NE 1/4, NW 1/4, Sec. 28 T19 R14 W</u> <u>1 1/2 miles SOUTH of GREENWOOD</u> (distance) (direction) (Nearest Town)	<u>GRAVEL</u>	<u>59</u>	<u>133</u>
(3) Topography:	<u>SAND</u>	<u>143</u>	<u>276</u>
(4) Purpose of Well: <u>MEAT PROCESSING PLANT</u> (Domestic Irrigation, Municipal, Industrial, Other)	<u>GUMBO</u>	<u>62</u>	<u>338</u>
	<u>SHALE W/4" ROCK</u>	<u>51</u>	<u>389</u>
	<u>SAND</u>	<u>16</u>	<u>405</u>
	<u>GUMBO</u>	<u>25</u>	<u>430</u>
	<u>SHALE W/3+5" ROCK</u>	<u>44</u>	<u>474</u>
	<u>SAND STREAKED SHALE</u>	<u>82</u>	<u>556</u>
	<u>SHALE W/4" ROCK</u>	<u>22</u>	<u>578</u>
	<u>GUMBO</u>	<u>23</u>	<u>601</u>
	<u>SHALE W/3+5" ROCK</u>	<u>19</u>	<u>620</u>
	<u>SAND W/2" ROCK</u>	<u>30</u>	<u>650</u>
	<u>GUMBO</u>	<u>13</u>	<u>663</u>
	<u>SHALE</u>	<u>42</u>	<u>705</u>
	<u>SAND</u>	<u>114</u>	<u>819</u>
	<u>GUMBO</u>	<u>13</u>	<u>832</u>
	<u>SAND</u>	<u>73</u>	<u>905</u>
Information upon completion of well:			
(1) Diameter <u>3</u> inches.			
(2) Total Depth <u>905</u> feet.			
(3) Water Level <u>WELL FLOWS</u> feet below top of ground.			
(4) Cased to <u>905</u> , Size <u>3 1/2"</u>			
(5) Screen: Size <u>2"</u> , Length <u>30'</u> <u>STAINLESS STEEL</u>			
(6) Were any formations sealed against pollution? ____ yes, _____ no.			
If YES depth of formation _____			
Why _____			
Drillers Remarks: _____			

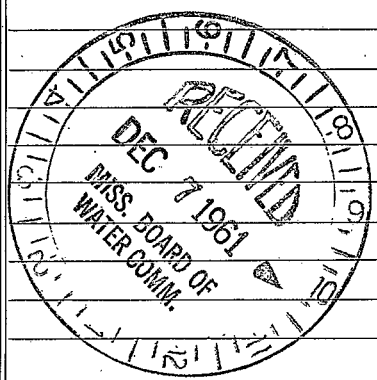

(Use Back Side)

Well No.

