

Leflore
L 99
3-7-75

MISSISSIPPI
BOARD OF WATER COMMISSIONERS
416 North State Street
Jackson, Mississippi 39201

CODED

WATER WELL DRILLERS LOG

March 7 1975 Bruce Berryman - Leflore
date well completed Greenwood, Miss. county well located


LANDOWNER: Mr. J.H. Stanton	description of formations encountered	from	to
P.O. Box 1236,	Clay	0	20
Greenwood, Miss. 38930	Sand	20	120
(mailing address)	Clay	120	180
	Greensand	180	300
WELL LOCATION:	Shale	300	320
sec. 17 T. 19 N. R. 2 E 155	Clay	320	340
4 miles east Greenwood	Sand	340	380
(distance) (direction) (nearest town)	Clay	380	430
WELL PURPOSE: Home	Sand	430	440
(home, irrigation, municipal, industrial)	Clay	440	480
WELL COMPLETION DATA:	Sand	480	500
(1) diameter (inches) 2"	Shale	500	530
(2) total depth (feet) 577'	Sand	530	545
(3) static water level (feet) 4' below top of ground	Shale	545	560
(4) casing 2" galv. pipe 567'	Sand	560	590
(material) (depth)	Clay	590	610
(size) if telescope see back.			
(5) screen 10' 567'			
(length) (depth to top)			
.010 stainless steel			
(size) (material)			
(6) pump 1/2 jet 5			
(HP) (yield gpm)			
Electric			
(type power)			
(7) electric log No.			
(yes or no)			
(organization running log)			
(8) how well bottom plugged B.P.V.			
DRILLERS REMARKS:			

DISCOVERED
MAY 24 1975

MISS. BD. OF WATER COMMISSIONERS

If well telescopes please sketch and show depths.

GROUND LEVEL

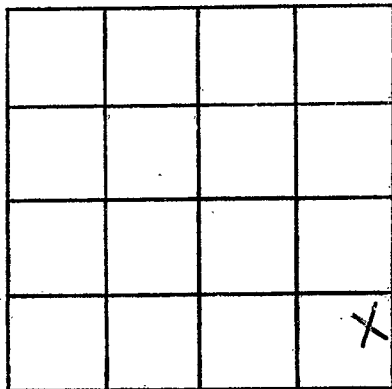

SECTION 17

Please indicate well location X.

ADDITIONAL INFORMATION

If more than one screen,
show locations of each on sketch.