

LeFlore
L123
3-24-61

WATER WELL DRILLERS LOG

h-308

Date: MAR. 24, 1961, Driller: DELTA DRILLING Co. County LEFLORE

(Name)

(1) Owner of Land: V. W. FLOWERS
(Name)

Description & Color of Materials Sand, Clay, Red Clay, Shell, etc.	Thick- ness Feet	Depth Feet.
GUMBO	32	32
SAND	45	77
GRAVEL CODED	57	134
SAND	35	169
GUMBO	57	226
GREEN SAND w/10" ROCK	24	250
SHALE w/9" ROCK	18	268
GREEN SAND w/10" ROCK	32	300
GREEN SAND MIXED w/ SHALE		
12" TO 18" ROCK	128	428
GREEN SHALE	62	490
GUMBO	16	506
SANDY SHALE w/ROCK	95	601
GUMBO	31	632
SHALE	30	662
FINE WHITE SAND	31	693
SAND w/ SHALE STREAKS.	44	737
WHITE SAND	33	770
CODED	11	781

RTE. 1, GREENWOOD, MISS
(Address)

(2) Location: NE 1/4 NE 1/4, Sec. 23 T9 R1 E

1/2 miles S. ON HIGHWAY 67 (GREENWOOD)
(distance) (direction) (Nearest Town)

(3) Topography: _____
(Hilly) (Flat) (Level)

(4) Purpose of Well: DOMESTIC
(Domestic Irrigation
Municipal, Industrial, Other)

Information upon completion of well:

(1) Diameter 3 inches.

(2) Total Depth 781 feet.

(3) Water Level FLOWS feet below top of ground.

(4) Cased to 781', Size 3" 449, Size 2" 318


(5) Screen: Size 2", Length 30'
16' LAP OF 2" IN 3" PIPE.

(6) Were any formations sealed against pollution?
_____ yes, _____ no.

If YES depth of formation _____

Why _____

Drillers Remarks: _____

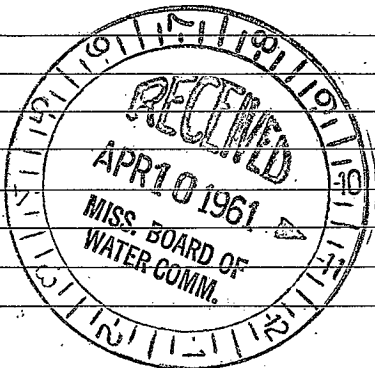

COMPLETE LEG LOG MADE BY USGS.

Well No.

(Use Back Side)

