

L-27 126  
6-4-65

WATER WELL DRILLERS LOG

**CODED**

Date: 6-4-1965, Driller: Layne-Central Co. County LeFlore

2980 9921 (Name)

- (1) Owner of Land: Staple Cotton Services Association, Inc.  
Greenwood, Mississippi  
(Address)
- (2) Location: 1/4, 1/4, Sec. 32 T19R1E,  
\_\_\_\_\_ miles \_\_\_\_\_ of \_\_\_\_\_  
(distance) (direction) (Nearest Town)
- (3) Topography: \_\_\_\_\_  
(Hilly) (Flat) (Level)
- (4) Purpose of Well: \_\_\_\_\_  
(Domestic Irrigation  
Municipal, Industrial, Other)


Description & Color of Materials Sand, Clay, Red Clay, Shell, etc.	Thick- ness Feet	Depth Feet
gumbo	14	14
brown soft clay	10	24
loose blue sand	16	40
sand-pea gravel	60	100
gravel-sand	85	185
rock	1	186
white sand	77	263
hard clay	100	363
sandy shale	37	400
sand (green)	26	426
rock	4	430
shale-sand stks	23	453
rock-stks clay	3	456
hard shale	28	484
rock	3	487
shale	33	520
sand	15	535
sand-stks shale	35	570
hard shale	35	655
sand	30	685
hard shale	43	728
sand	20	748
hard shale	16	764
h.p. coarse sand	50	814

Information upon completion of well:

- (1) Diameter 8" inches.
- (2) Total Depth 821 feet.
- (3) Water Level 17' feet below top of ground.
- (4) Cased to 770', Size 8"
- (5) Screen: Size 6", Length 40'
- (6) Were any formations sealed against pollution?  
X yes, \_\_\_\_\_ no.

If YES depth of formation 770'  
Why \_\_\_\_\_ required

Drillers Remarks: \_\_\_\_\_

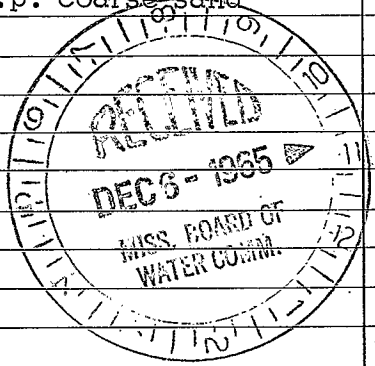

(Use Back Side)

Well No.

