

Before
 L 141
 8-20-62

MISSISSIPPI BOARD OF WATER COMMISSIONERS

WATER WELL DRILLERS LOG CODED

Date: AUG. 20, 1962, Driller: DELTA DRILLING Co. County LEFLORE

(Name)

(1) Owner of Land: FOAAD MALOUF
 (Name)

GREENWOOD, MISS
 (Address)

(2) Location: NE 1/4, NE 1/4, Sec. 1 T20N R1E
 _____ miles _____ of _____
 (distance) (direction) (Nearest Town)

(3) Topography: _____
 (Hilly) (Flat) (Level)

(4) Purpose of Well: DOMESTIC
 (Domestic Irrigation
 Municipal, Industrial, Other)


Information upon completion of well:

- (1) Diameter 3 inches.
- (2) Total Depth 716 feet.
- (3) Water Level WELL FLOWS feet below top of ground.
- (4) Cased to 716, Size 3 x 2"
- (5) Screen: Size 2", Length 30'
- (6) Were any formations sealed against pollution?
 _____ yes, no.

If YES depth of formation _____
 Why _____

Drillers Remarks: 17' LAP OF 2" IN 3" PIPE - WELL SET 662' WITH 32'- 2" TAIL PIPE ON BOTTOM OF SCREEN.

| Description & Color of Materials Sand, Clay, Red Clay, Shell, etc. | Thick-ness Feet | Depth Feet |
|---|--------------------|---------------|
| SAND | 94 | 94 |
| GRAVEL | 32 | 126 |
| SHALE | 22 | 148 |
| SAND | 24 | 172 |
| GUMBO w/10" ROCK | 42 | 214 |
| GREEN SAND w/8" ROCK | 58 | 272 |
| SHALE CODED | 39 | 311 |
| GREEN SAND | 82 | 393 |
| SHALE | 78 | 471 |
| SAND | 76 | 547 |
| BROWN SAND | 52 | 599 |
| GUMBO | 29 | 628 |
| SAND | 88 | 716 |

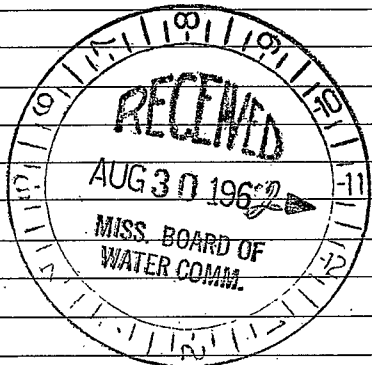

(Use Back Side)

Well No.

[The page contains extremely faint and illegible text, likely bleed-through from the reverse side of the document. No specific words or phrases can be discerned.]