

Leflore  
L 142  
3-23-62

MISSISSIPPI BOARD OF WATER COMMISSIONERS

WATER WELL DRILLERS LOG

CODED

Date: MARCH 23, 1962, Driller: DELTA DRILLING Co. County LEFLORE

(Name)

(1) Owner of Land: <u>CAMPBELL "66" EXPRESS</u> (Name)	Description & Color of Materials Sand, Clay, Red Clay, Shell, etc.	Thick- ness Feet	Depth Feet
<u>GREENWOOD, MISS.</u> (Address)	TOP SOIL	11	11
(2) Location: <u>NE 1/4, SW 1/4, Sec. 13 T48R1E,</u> <u>1/2 miles EAST</u> of <u>GREENWOOD</u> (distance) (direction) (Nearest Town)	SAND	70	81
(3) Topography: _____ (Hilly) (Flat) (Level)	GRAVEL	50	131
(4) Purpose of Well: _____ (Domestic Irrigation Municipal, Industrial, Other)	SAND	105	236
	GUMBO	45	281
	SHALE	60	341
	GREEN SAND	35	376
	SHALE <b>CODED</b>	40	416
	SAND	51	467


Information upon completion of well:

- (1) Diameter 2 inches.
- (2) Total Depth 467 feet.
- (3) Water Level WELL FLOWS feet below top of ground.
- (4) Cased to \_\_\_\_\_, Size 2"
- (5) Screen: Size 2", Length 60' PER FORATED PIPE
- (6) Were any formations sealed against pollution?  
\_\_\_\_\_ yes, \_\_\_\_\_ no.

If YES depth of formation: \_\_\_\_\_

Why: \_\_\_\_\_

Drillers Remarks: \_\_\_\_\_

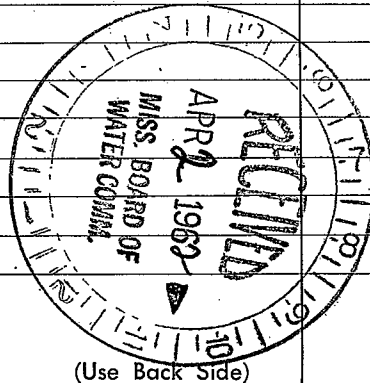

(Use Back Side)

Well No.

