

Leflore

MISSISSIPPI BOARD OF WATER COMMISSIONERS

L 144
2-23-63

WATER WELL DRILLERS LOG CODED

Date: FEB. 23, 1963, Driller: DELTA DRILLING Co. County LEFLORE
(Name)

(1) Owner of Land: E. B. BOGGAN
(Name)
GREENWOOD MISS
(Address)

(2) Location: NW 1/4, SE 1/4, Sec. 21 T9N R1E
_____ miles _____ of _____
(distance) (direction) (Nearest Town)

(3) Topography: FLAT
(Hilly) (Flat) (Level)

(4) Purpose of Well: DOMESTIC
(Domestic Irrigation
Municipal, Industrial, Other)

Description & Color of Materials Sand, Clay, Red Clay, Shell, etc.	Thick- ness Feet	Depth Feet
GUMBO	43	43
FINE SAND	21	64
GRAVEL	75	139
SAND	137	276
GUMBO	60	336
SHALE w/ 4-5" ROCKS	65	401
CODED	38	439
SHALE	41	480
GREEN SAND w/ ROCK	22	502
SHALE w/ ROCK	20	522
FINE SAND	38	560
SHALE	25	585
SAND	45	630

Information upon completion of well:

(1) Diameter 2 inches.

(2) Total Depth 630 feet.

(3) Water Level FLOWS feet below top of ground.

(4) Cased to 588, Size 2"


(5) Screen: Size 2", Length 42'
PERFORATED PIPE

(6) Were any formations sealed against pollution?
_____ yes, _____ no.

If YES depth of formation _____

Why _____

Drillers Remarks: WELL FLOWS 10 GPM

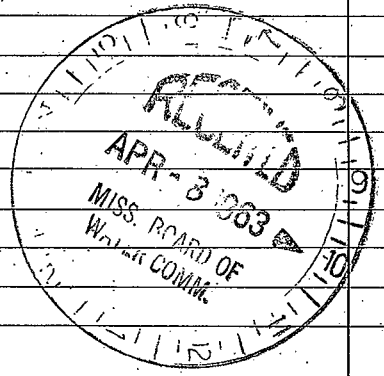

(Use Back Side)

Well No.

