

Leflore
L 145
6-17-63

MISSISSIPPI BOARD OF WATER COMMISSIONERS

WATER WELL DRILLERS LOG

CODED

Date: JUNE 17, 1963, Driller: DELTA DRILLING Co County LEFLORE
(Name)

(1) Owner of Land: GEORGE YOUNG
(Name)
GREENWOOD, MISS.
(Address)

(2) Location: NW 1/4, SW 1/4, Sec. 17 T4N R2E
_____ miles _____ of _____
(distance) (direction) (Nearest Town)

(3) Topography: _____
(Hilly) (Flat) (Level)

(4) Purpose of Well: DOMESTIC
(Domestic Irrigation
Municipal, Industrial, Other)


Information upon completion of well:

- (1) Diameter 4 inches.
- (2) Total Depth 663 feet.
- (3) Water Level WELL FLOWS feet below top of ground.
- (4) Cased to 643, Size 2 1/2" - 2.37
- (5) Screen: Size 2 1/2, Length 20'
- (6) Were any formations sealed against pollution?
_____ yes, _____ no.

If YES depth of formation _____
Why _____

Drillers Remarks: 20' GAP OF 2 1/2"
IN 4"

Description & Color of Materials Sand, Clay, Red Clay, Shell, etc.	Thick- ness Feet	Depth Feet
SAND	86	86
GRAVEL	42	128
SAND	34	162
GUMBO w/5" ROCK-	30	192
SHALE CODED	30	222
SAND w/5" ROCK-	34	256
GUMBO	16	272
SAND w/ROCK-	30	302
GUMBO w/ROCK-	26	328
SHALE	98	426
SAND	22	448
SHALE w/ROCK	28	476
GUMBO	11	487
SHALE	36	523
GREEN SAND	20	543
SAND	40	583
SHALE	20	603
SAND	60	663

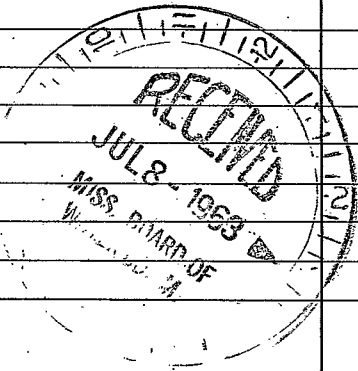

(Use Back Side)

Well No.

