


L 146  
5-23-63

WATER WELL DRILLERS LOG CODED

Date: MAY 23, 1963, Driller: DELTA DRILLING Co. County LEFLORE

(Name)

		Description & Color of Materials Sand, Clay, Red Clay, Shell, etc.	Thick- ness Feet	Depth Feet
(1) Owner of Land: <u>FT. PEMBERTON MEMORIAL</u> (Name) <u>PARK</u>		<u>SAND</u>	<u>65</u>	<u>65</u>
<u>GREENWOOD, MISS.</u> (Address)		<u>GRAVEL</u>	<u>20</u>	<u>85</u>
(2) Location: <u>NW 1/4, NE 1/4, Sec. 7 T. 1 N. R. 15 E.</u>		<u>SAND</u>	<u>22</u>	<u>107</u>
<u>49-82 INTER</u> miles <u>EAST</u> , of <u>SECTION</u> (distance) (direction) (Nearest Town) <u>GREENWOOD</u>		<u>GRAVEL</u>	<u>20</u>	<u>127</u>
(3) Topography: <u>FLAT</u> (Hilly) (Flat) (Level)		<u>SAND</u>	<u>146</u>	<u>273</u>
(4) Purpose of Well: (Domestic Irrigation Municipal, Industrial, Other)		<u>GUMBO</u>	<u>68</u>	<u>341</u>
Information upon completion of well:		<u>SHALE w/6" ROCK-</u>	<u>52</u>	<u>393</u>
(1) Diameter <u>2</u> inches.		<u>GUMBO</u>	<u>26</u>	<u>419</u>
(2) Total Depth <u>832</u> feet.		<u>GREENODED</u>	<u>35</u>	<u>454</u>
(3) Water Level <u>WELL FLOWS</u> feet below top of ground.		<u>SHALE w/4" ROCK</u>	<u>70</u>	<u>524</u>
(4) Cased to <u>822</u> , Size <u>2"</u>		<u>GREEN SAND</u>	<u>52</u>	<u>576</u>
(5) Screen: Size <u>2"</u> , Length <u>10'</u>		<u>SHALE w/8" ROCK-</u>	<u>36</u>	<u>612</u>
(6) Were any formations sealed against pollution? _____ yes, _____ no.		<u>SAND</u>	<u>28</u>	<u>640</u>
If YES depth of formation _____		<u>GUMBO</u>	<u>30</u>	<u>670</u>
Why _____		<u>SHALE</u>	<u>33</u>	<u>703</u>
Drillers Remarks: _____		<u>GUMBO</u>	<u>32</u>	<u>735</u>
		<u>SHALE</u>	<u>6</u>	<u>741</u>
		<u>GREEN SAND</u>	<u>37</u>	<u>778</u>
		<u>GUMBO</u>	<u>11</u>	<u>789</u>
		<u>SAND-</u>	<u>43</u>	<u>832</u>

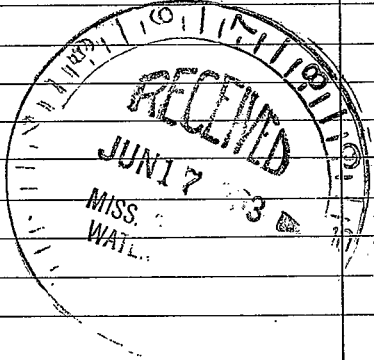

(Use Back Side)

Well No.

