

dated L 155
E 109 152

LEFLORE
L 155
10-30-64

MISSISSIPPI
BOARD OF WATER COMMISSIONERS
416 North State Street
Jackson, Mississippi 39201

WATER WELL DRILLERS LOG


Oct 30 1964 date well completed Delta Drilling Co firm name Weflore county well located

LANDOWNER: Chapman Bros. & S. C. Frederick	description of formations encountered	from	to
Rt 2 Greenwood, Miss. (mailing address)	Top soil & sand	0	50
WELL LOCATION: SW x NE	Hambo	50	66
sec. 1 T 19 N S R 1 E W	Sand	66	82
_____ miles (distance) of _____ (direction) of _____ (nearest town)	Gravel	82	156
WELL PURPOSE: sub-division (home, irrigation, municipal, industrial)	Sand	156	178
WELL COMPLETION DATA:	Hambo w/ Rock	178	230
(1) diameter (inches) 4	Shale	230	272
(2) total depth (feet) 709	Greensand w/ Rocks	272	312
(3) static water level (feet) well below top of ground. 8# PSD shut in	Shale w/ Rock	312	353
(4) casing Steel 689 (material) (depth)	Sand w/ Rock	353	375
4" 3" 2" if telescope see back. (size)	Shale	375	489
(5) screen 20' (length) (depth to top) 2" Stainless Steel (size) (material)	Hambo	489	509
(6) pump 3 (HP) 60 (yield gpm)	Shale	509	569
Elec (type power)	Sand	569	595
(7) electric log YES (yes or no)	Shale	595	615
Miss Geo. Survey. (organization running log)	Sand	615	635
(8) how well bottom plugged B.P. NAWE	Shale	635	650
	White sand	650	709

DRILLERS REMARKS: 20' lap of 2 1/2" in 3" pipe well flows 100 gpm 5# PSD. Shut in.

If well telescopes please sketch and show depths.

GROUND LEVEL

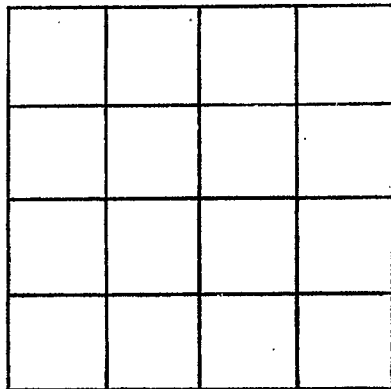

SECTION _____

Please indicate well location X.

ADDITIONAL INFORMATION

If more than one screen,
show locations of each on sketch.