

L157
2-13-64

WATER WELL DRILLERS LOG

CODED

Date: 2-13-, 1964, Driller: Layne-Central Co. County Leflore
(Name)

(1) Owner of Land: Greenwood Utilities

(Name)

Greenwood, Mississippi

(Address)

(2) Location: NE 1/4, NW 1/4, Sec. 15 T19N R1E

 miles , of
(distance) (direction) (Nearest Town)

(3) Topography:
(Hilly) (Flat) (Level)

(4) Purpose of Well: Municipal
(Domestic Irrigation
Municipal, Industrial, Other)

Information upon completion of well:

- (1) Diameter 24" inches.
(2) Total Depth 130' feet.
(3) Water Level 42' feet below top of ground.
(4) Cased to 70', Size 24"
(5) Screen: Size 16", Length 60'
(6) Were any formations sealed against pollution?
 X yes, no.

If YES depth of formation 70'

Why required

Drillers Remarks:


Description & Color of Materials
Sand, Clay, Red Clay, Shell, etc.

Thick-
ness
Feet

Depth
Feet

| | | |
|------------------------|----|-----|
| gumbo | 20 | 20 |
| soft blue clay | 12 | 32 |
| sand-clay stks | 3 | 35 |
| coarse sand-pea gravel | 35 | 70 |
| coarse gravel-sand | 19 | 89 |
| clay break | 1 | 90 |
| coarse sand-pea gravel | 28 | 118 |
| clay-sand stks | 12 | 130 |
| | | |
| | | |
CODED

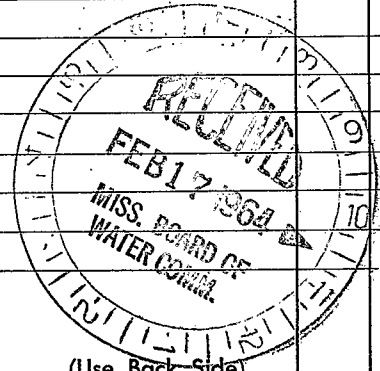

Well No.

(Use Back Side)

