

Leflore  
 L159  
 7-66

DECOMMISSIONING 9/21/99  
 MISSISSIPPI BOARD OF WATER COMMISSIONERS / ELOG #66

WATER WELL DRILLERS LOG CODED

Date: JULY 18, 1966, Driller: DELTA DRILLING Co. County LEFLORE

(Name)

(1) Owner of Land: COUNTRY CLUB UTILITY  
GEORGE YOUNG  
 (Name)  
GREENWOOD, MISS.  
 (Address)

(2) Location: SW 1/4, SE 1/4, Sec. 13 TANKLE  
1/2 miles SE of Greenwood  
 (distance) (direction) (Nearest Town)

(3) Topography: \_\_\_\_\_  
 (Hilly) (Flat) (Level)

(4) Purpose of Well: MUNICIPAL  
 (Domestic Irrigation  
 Municipal, Industrial, Other)

Description & Color of Materials Sand, Clay, Red Clay, Shell, etc.	Thick- ness Feet	Depth Feet
Gumbo -	42	42
Sand	22	64
gravel	50	114
Sand	39	153
gumbo w/ROCKS -	90	243
Shale	20	263
Sand w/ROCKS	62	325
Shale	20	345
Sand w/ROCKS -	50	395
Shale	75	470
sand	44	514
Shale	50	564
Sand	29	593
Shale	21	614
Sand	54	668
Shale	29	697
Sand	41	738
gumbo	2	740

Information upon completion of well:

(1) Diameter 6 inches.

(2) Total Depth 740 feet.

(3) Water Level FLOWS feet below top of ground. 375' 6"


(4) Cased to 740, Size 350' 4"

(5) Screen: Size 4", Length 30

(6) Were any formations sealed against pollution?  
X yes, \_\_\_\_\_ no.

If YES depth of formation 375'  
TO SHUT OFF SURFACE  
 Why FORMATION

Drillers Remarks: 15' LAP OF 4" IN 6"  
PIPE - W/16" - 4" TAIL PIPE  
ON BOTTOM OF WELL -

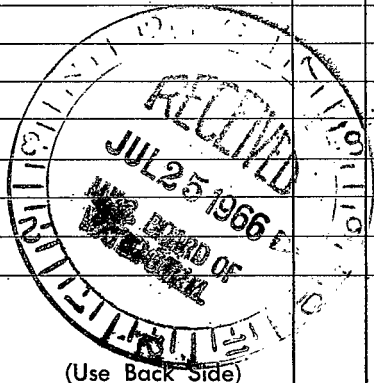

(Use Back Side)

Well No.

