

CODED

Leflore

4161

11-67

MISSISSIPPI
BOARD OF WATER COMMISSIONERS
416 North State Street
Jackson, Mississippi 39201

CODED

WATER WELL DRILLERS LOG

Nov 1, 1967
date well completed

1967 DELTA DRILLING Co.
firm name

LEFLORE
county well located

LANDOWNER: G.C. FREDERICK-
SUB-DIVISION

RT. 2, GREENWOOD

MISS

(mailing address)

WELL LOCATION: S.W/4 NE/4

sec. 1 T. 19 N. R. 1 E
19 X X

_____ miles _____ of _____
(distance) (direction) (nearest town)

WELL PURPOSE: MUNICIPAL
(home, irrigation, municipal, industrial)

WELL COMPLETION DATA:

- (1) diameter (inches) 4"
- (2) total depth (feet) 716
- (3) static water level (feet) Flows ^{below} top of ground. 4:09 P.M. ^{above}
- (4) casing STEEL, 696
(material) (depth)
4x2 1/2
(size) if telescope see back.
- (5) screen 20, 696'
(length) (depth to top)
2 1/2", S. Steel
(size) (material)
- (6) pump (HP) (yield gpm)
(type power)
- (7) electric log NO
(yes or no)
(organization running log)


(8) how well bottom plugged BACK PRESSURE VALVE

description of formations encountered

from to

gumbo	24	24
Sand	24	97
gravel	97	127
gumbo w/rocks	127	252
Shale	252	293
Sand	293	315
Shale	315	373
Sand	373	396
Shale	396	474
Sand	474	556
Shale	556	603
gumbo	603	613
White Sand	613	716

DRILLERS REMARKS: 20' LAP OF 2 1/2" PIPE IN 4" PIPE

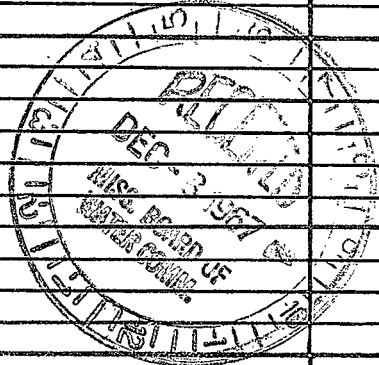

If well telescopes please sketch and show depths.

GROUND LEVEL

450' 4"
BLK A.P. 1
LINE PIPE

20' LAP OF
2 1/2" PIPE IN
4" PIPE

266' 2 1/2" BLK
API LINE PIPE

20' STAINLESS
STEEL SCREEN

7' 16" DEPTH

2 1/2" B. P.
VALVE

X			

SECTION 1

Please indicate well location X.

ADDITIONAL INFORMATION

If more than one screen,
show locations of each on sketch.