

**LeFLORE**  
**L161**  
**11-1-67**

MISSISSIPPI  
 BOARD OF WATER COMMISSIONERS  
 416 North State Street  
 Jackson, Mississippi 39201

L161


**WATER WELL DRILLERS LOG**

Nov 1 1967 Delta Drilling Co LeFlore  
 date well completed firm name county well located

LANDOWNER:	description of formations encountered	from	to
<u>C.G. Frederick</u>	<u>Gumbo</u>	<u>60</u>	<u>24</u>
<u>Rt 2 Green wood, Miss</u>	<u>Sand</u>	<u>24</u>	<u>97</u>
<u>(mailing address)</u>	<u>Gravel</u>	<u>97</u>	<u>127</u>
<u>WELL LOCATION:</u>	<u>Gumbo w/Rocks</u>	<u>127</u>	<u>252</u>
sec. <u>1</u> T <u>19</u> N R <u>1</u> E SWXNE	<u>Shale</u>	<u>252</u>	<u>273</u>
§	<u>Sand</u>	<u>273</u>	<u>315</u>
_____ miles of _____	<u>Shale</u>	<u>315</u>	<u>373</u>
(distance) (direction) of (nearest town)	<u>Sand</u>	<u>373</u>	<u>396</u>
<u>WELL PURPOSE: SUB-DIV</u>	<u>Shale</u>	<u>396</u>	<u>474</u>
(home, irrigation, municipal, industrial)	<u>Sand</u>	<u>474</u>	<u>556</u>
<u>WELL COMPLETION DATA:</u>	<u>Shale</u>	<u>556</u>	<u>603</u>
(1) diameter (inches) <u>4"</u>	<u>Gumbo</u>	<u>603</u>	<u>613</u>
(2) total depth (feet) <u>716'</u>	<u>White Sand</u>	<u>613</u>	<u>716</u>
(3) static water level (feet) <u>flows</u> below top of ground.			
(4) casing <u>Steel</u> <u>696</u> (material) (depth)			
_____ if telescope see back. (size)			
(5) screen <u>20</u> <u>676</u> (length) (depth to top)			
<u>2 1/2</u> <u>S. Steel</u> (size) (material)			
(6) pump <u>1 1/2</u> <u>40</u> (HP) (yield gpm)			
<u>Electric</u> (type power)			
(7) electric log <u>No</u> (yes or no)			
_____ (organization running log)			
(8) how well bottom plugged _____			
<u>DRILLERS REMARKS:</u>			

If well telescopes please sketch and show depths.

GROUND LEVEL

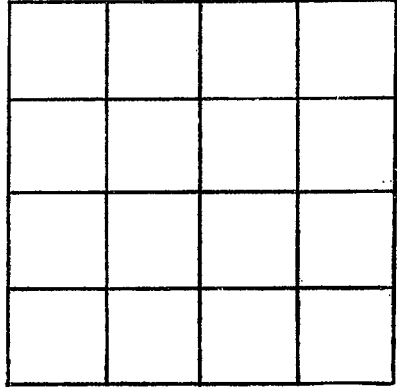

SECTION \_\_\_\_\_

Please indicate well location X.

ADDITIONAL INFORMATION

If more than one screen, show locations of each on sketch.