

CODED

MISSISSIPPI  
BOARD OF WATER COMMISSIONERS  
416 North State Street  
Jackson, Mississippi 39201

CODED CODED

WATER WELL DRILLERS LOG

Leflore  
L163  
10-23-68

10/23/68 date well completed      19. Butane Gas Co. of G'wood firm name      Leflore county well located

LANDOWNER:

Emmett Bond

description of formations encountered

from to

Greenwood, Miss.  
(mailing address)

<u>Clay</u>	<u>0</u>	<u>40</u>
<u>SAND &amp; GRAVEL</u>	<u>40</u>	<u>170</u>
<u>SHALE</u>	<u>170</u>	<u>250</u>
<u>GREEN SAND</u>	<u>250</u>	<u>300</u>
<u>SHALE</u>	<u>300</u>	<u>510</u>
<u>GREEN SAND</u>	<u>510</u>	<u>530</u>
<u>WHITE SAND</u>	<u>530</u>	<u>555</u>


WELL LOCATION:

sec 1 T 19 N R 1 E  
1/2 miles NE of G'WOOD  
(distance) (direction) (nearest town)

WELL PURPOSE: Home  
(home, irrigation, municipal, industrial)

WELL COMPLETION DATA:

- (1) diameter (inches) 2"
- (2) total depth (feet) 555
- (3) static water level (feet) 10 below top of ground.
- (4) casing Steel, 535,  
(material) (depth)  
2" if telescope see back.  
(size)
- (5) screen 20', 535  
(length) (depth to top)  
2", Stainless Steel  
(size) (material)
- (6) pump 3/4, 10  
(HP) (yield gpm)  
Elec.  
(type power)
- (7) electric log No  
(yes or no)  
  
(organization running log)
- (8) how well bottom plugged  
Back Pressure Valve

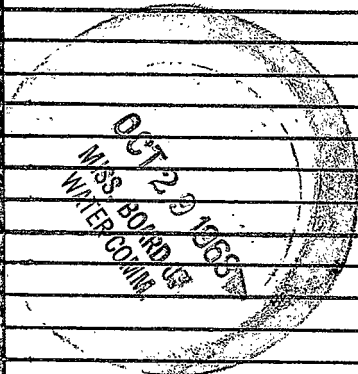

DRILLERS REMARKS:

If well telescopes please sketch and show depths.

GROUND LEVEL

			+

SECTION 1

Please indicate well location X.

ADDITIONAL INFORMATION

If more than one screen, show locations of each on sketch.