

LEFLORE

L 166

12/30/68

MISSISSIPPI
 BOARD OF WATER COMMISSIONERS
 416 North State Street
 Jackson, Mississippi 39201

CODED

CODED

WATER WELL DRILLERS LOG

12-30

19

68 DYER WELL TRP.

LEFLORE

date well completed

firm name

county well located

LANDOWNER:

JOHN BUNNICK

GREENWOOD, MISS.

(mailing address)

WELL LOCATION:

sec. 28 T. 19 N. R. 1 E
~~S~~ ~~W~~
1 1/2 miles SO of GREENWOOD
 (distance) (direction) (nearest town)

WELL PURPOSE: IND.
 (home, irrigation, municipal, industrial)

WELL COMPLETION DATA:

- (1) diameter (inches) 4" x 2 1/2"
- (2) total depth (feet) 452
- (3) static water level (feet) 0 below above top of ground.
- (4) casing 4" BUR. 168 (material) 2 1/2" BUR. 364 (depth)
- (size) if telescope see back.
- (5) screen 20' 432' (length) (depth to top)
2 1/2" STAINLESS STEEL (size) (material)
- (6) pump 3 70 (HP) (yield gpm)
ELEC (type power)
- (7) electric log X/O (yes or no)
(organization running log)
- (8) how well bottom plugged VALVE

description of formations encountered

from

to

CLAY	0	12
SAND	12	89
GRAVEL	89	110
SAND + GRAVEL	110	155
SAND + SHALE ST.	155	228
SAND	228	268
Gummy SHALE	268	325
SHALE ROCK ST.	325	351
SAND SHALE	351	378
SAND	378	419
CLAY	419	436
SAND	436	452
Gummy SHALE	452	460

LOSER

FEB 17 1969


MISS. BD. OF WATER COMM.

DRILLERS REMARKS:

If well telescopes please sketch and show depths.

GROUND LEVEL

*Connected with
swellage in pipe.
No. large pipe.*

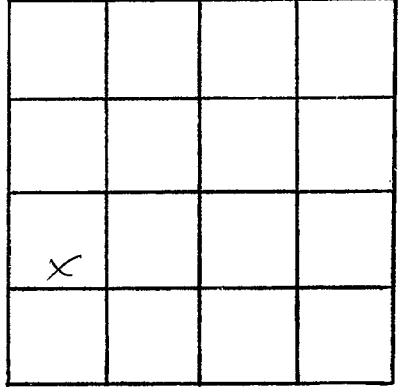

SECTION 28

Please indicate well location X.

ADDITIONAL INFORMATION

If more than one screen,
show locations of each on sketch.