

CODED

CODED

Leflore
L167
2-18-69

MISSISSIPPI
BOARD OF WATER COMMISSIONERS
416 North State Street
Jackson, Mississippi 39201
WATER WELL DRILLERS LOG

FEB 18 1969 DELTA DRILLING Co LEFLORE
date well completed firm name county well located

LANDOWNER: LEO MURPHREE
RT. 1

description of formations encountered from to

GREENWOOD, MISS
(mailing address)

GUMBO -0- 31
SAND 31 78
GRAVEL 78 124
SAND 124 170

WELL LOCATION:
sec. 23 T. 19 N R. 1 E
3 miles SE of GREENWOOD
(distance) (direction) (nearest town)

SHALE 170 226
GUMBO 226 269
GREEN SAND 269 310
SHALE 310 351

WELL PURPOSE: DOMESTIC
(home, irrigation, municipal, industrial)

GREEN SAND W/ROCKS 351 412
SHALE 412 451
GREEN SAND 451 493

WELL COMPLETION DATA:

GUMBO 493 534

(1) diameter (inches) 4
(2) total depth (feet) 764

SHALE 534 560
GREEN SAND W/ROCK 560 585

(3) static water level (feet) FLOWS below top of ground.

SHALE 585 636
SAND 636 649

(4) casing STEEL, 722, 4" (material), (depth), 2" (size) if telescope see back.

SHALE 649 702
SAND 702 745
SHALE 745 764

(5) screen 20, 722 (length), (depth to top), 2" STAINLESS STEEL (size), (material)

(6) pump V, FLOW APPROX 20 (HP), (yield gpm), (type power)

(7) electric log NO (yes or no), (organization running log)


(8) how well bottom plugged BACK PRESSURE VALVE

MAR 17 1969

MISS. BD. OF WATER COMM.

DRILLERS REMARKS: WELL SET 742' - 25' LAP OF 2" IN 4" PIPE - 22' - 2" TAIL PIPE ON BOTTOM OF WELL.

If well telescopes please
 sketch and show depths.

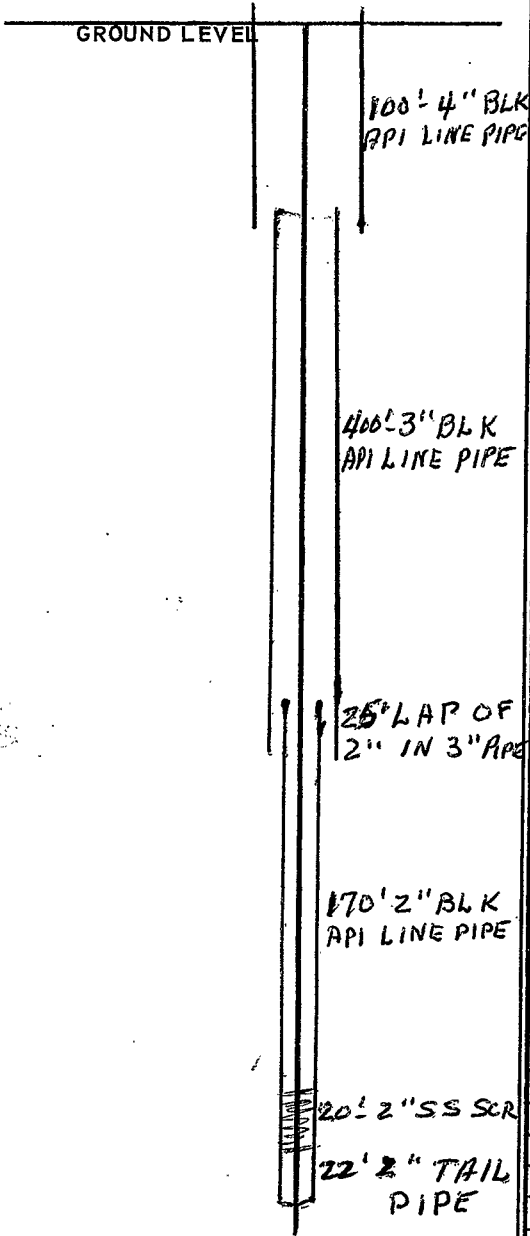

SECTION 23

Please indicate well location X.

ADDITIONAL INFORMATION

If more than one screen,
 show locations of each on sketch.