

LEFLORE  
 L-169  
 9-14-70

MISSISSIPPI  
 BOARD OF WATER COMMISSIONERS  
 416 North State Street  
 Jackson, Mississippi 39201

**CODED**

WATER WELL DRILLERS LOG

DYER WELL & IRRIGATION SERVICE LEFLORE

Sept 14 1970 date well completed  
 firm name  
 county well located

LANDOWNER <i>Greenwood Memorial Care</i>	Description of formations encountered	from	to
		<i>BREENWARD</i>	<i>Clay</i>
<i>MISS.</i>	<i>Clay</i>	<i>22</i>	<i>42</i>
(mailing address)	<i>Clay</i>	<i>42</i>	<i>82</i>
	<i>Sand</i>	<i>82</i>	<i>102</i>

WELL LOCATION:  
 sec *28* T *19N* R *10E*  
*1 1/2* miles *S* of *GREENWOOD*  
 (distance) (direction) (nearest town)

WELL PURPOSE: *DRINK*  
 (home, irrigation, municipal, industrial)

- WELL COMPLETION DATA:
- (1) diameter (inches) *2"*
  - (2) total depth (feet) *94'*
  - (3) static water level (feet) *12'* below above top of ground.
  - (4) casing *Galv* *84'*  
 (material) (depth)  
 (size) if telescope see back.
  - (5) screen *10'* *84'*  
 (length) (depth to top)  
*2 1/2"* *PLASTIC*  
 (size) (material)
  - (6) pump *1* *10*  
 (HP) (yield gpm)  
*ELEC*  
 (type power)
  - (7) electric log *No*  
 (yes or no)
  - (organization running log)
  - (8) how well bottom plugged *BRD.*

**CODED**


SEP 16 1970

DRILLERS REMARKS:

MISS. BD. OF  
 WATER COMM.

If well telescopes please sketch and show depths.

GROUND LEVEL

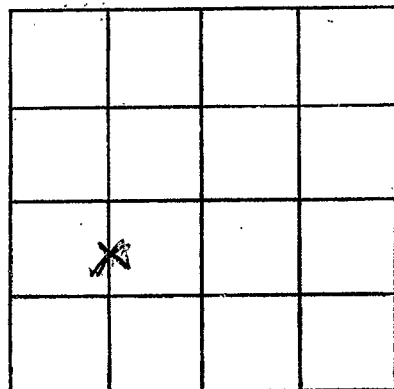

SECTION 28

Please indicate well location X.

ADDITIONAL INFORMATION

If more than one screen,  
show locations of each on sketch.