

LEFLORE
L170
10-7-70

MISSISSIPPI
BOARD OF WATER COMMISSIONERS
416 North State Street
Jackson, Mississippi 39201

CODED

WATER WELL DRILLERS LOG

BUTANE GAS CO. OF GREENWOOD

Leflore

Oct 7 1970
date well completed

firm name

county well located

LANDOWNER:

L.W. WADE

Greenwood, Miss.
(mailing address)

description of formations encountered

from

to

CLAY	0	18
SAND	18	60
SAND + GRAVEL	60	90

WELL LOCATION:

sec. 6 T 19 N R 1 E
1 miles SW of Greenwood
(distance) (direction) (nearest town)

WELL PURPOSE: Home
(home, irrigation, municipal, industrial)

WELL COMPLETION DATA:

- (1) diameter (inches) 2"
- (2) total depth (feet) 90
- (3) static water level (feet) 18 below above top of ground.
- (4) casing Steel, 80,
(material) (depth)
2" if telescope see back.
(size)
- (5) screen 10', 80
(length) (depth to top)
2", PVC
(size) (material)
- (6) pump 3/4, 10
(HP) (yield gpm)
Elec
(type power)
- (7) electric log No
(yes or no)

CODED

(organization running log)

(8) how well bottom plugged
Lead Plug


OCT 9 1970

DRILLERS REMARKS:

MISS. BD. OF
WATER COMM.

If well telescopes please sketch and show depths.

GROUND LEVEL

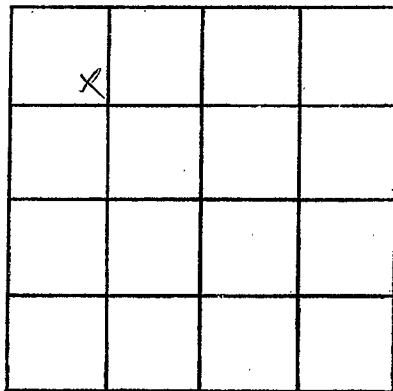

SECTION 6

Please indicate well location X.

ADDITIONAL INFORMATION

If more than one screen, show locations of each on sketch.