

MISSISSIPPI
 BOARD OF WATER COMMISSIONERS
 416 North State Street
 Jackson, Mississippi 39201

CODED

WATER WELL DRILLERS LOG
 DYER WELL & IRRIGATION SERVICE

Leflore
 county well located

LEFLORE
L171
11-3-70

11-3-70 19
 date well completed

firm name

LANDOWNER:
DANIEL REYNOLDS
R.R. Sison, Miss
 (mailing address)

description of formations encountered	from	to
<i>CLAY</i>	<i>0</i>	<i>18</i>
<i>SAND-GRAVEL</i>	<i>18</i>	<i>155</i>
<i>SAND</i>	<i>155</i>	<i>190</i>
<i>CLAY</i>	<i>190</i>	<i>270</i>
<i>GREEN-SAND</i>	<i>270</i>	<i>322</i>

WELL LOCATION:
 sec *35* T *19* N R *1* E
3 miles *S.E.* of *G-WOOD*
 (distance) (direction) (nearest town)

WELL PURPOSE: *HOME*
 (home, irrigation, municipal, industrial)

- WELL COMPLETION DATA:
- (1) diameter (inches) *2"*
 - (2) total depth (feet) *322'*
 - (3) static water level (feet) *0* below above top of ground.
 - (4) casing *2" cas.* (material) *312* (depth)
 - (size) if telescope see back.
 - (5) screen *10'* (length) *312* (depth to top)
2" (size) *STAINLESS STEEL* (material)
 - (6) pump *1/3* (HP) *6* (yield gpm).
ELEC (type power)
 - (7) electric log *NO* (yes or no)
 (organization running log)
 - (8) how well bottom plugged *B.P. Howe*

CODED


DRILLERS REMARKS:

NOV 23 1970

MISSISSIPPI
 WATER

If well telescopes please sketch and show depths.

GROUND LEVEL

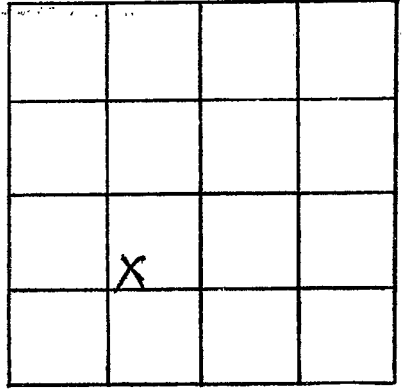

SECTION 35

Please indicate well location X.

ADDITIONAL INFORMATION

If more than one screen,
show locations of each on sketch.