

LEFLORE

L 172

11-5-70

MISSISSIPPI
 BOARD OF WATER COMMISSIONERS
 416 North State Street
 Jackson, Mississippi 39201

CODED

WATER WELL DRILLERS LOG
 DYER WELL & IRRIGATION SERVICE

LEFLORE

11-5-70 19
date well completed

firm name

county well located

LANDOWNER:

Ralph Johnson

GREENWOOD, MISS.
(mailing address)

description of formations encountered

Clay
Sand

from

to

0 38
38 82

WELL LOCATION:

sec. 9 T. 19 N. R. 1 E
miles of E-WOOD
(distance) (direction) (nearest town)

WELL PURPOSE: Home
(home, irrigation, municipal, industrial)

WELL COMPLETION DATA:

- (1) diameter (inches) 2"
- (2) total depth (feet) 82'
- (3) static water level (feet) 23' below top of ground.
- (4) casing 2" galv (material) 72' (depth)
- 2" (size) If telescope see back.
- (5) screen 10' (length) 72' (depth to top)
- 2" Plastic (size) (material)
- (6) pump 1/2 (HP) 10 (yield gpm)
- ELEC (type power)
- (7) electric log No (yes or no)

CODED

(organization running log)

(8) how well bottom plugged B.P. Vawter

DRILLERS REMARKS:


This well is in Greenwood City limits

NOV 23 1970

MISS. BD. OF WATER

If well telescopes please sketch and show depths.

GROUND LEVEL

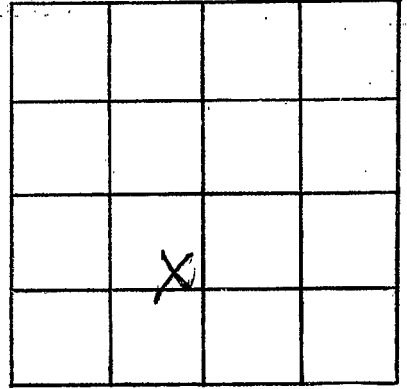

SECTION 9

Please indicate well location X.

ADDITIONAL INFORMATION

If more than one screen,
show locations of each on sketch.