

LEFLORE
L173
6-15-71

MISSISSIPPI
BOARD OF WATER COMMISSIONERS
416 North State Street
Jackson, Mississippi 39201

CODED

WATER WELL DRILLERS LOG

BUTANE GAS CO. OF GREENWOOD

POST OFFICE BOX 1135

GREENWOOD, MISS. 38930

6-15-71
date well completed

Leflore

county well located

LANDOWNER: C.S. Whittington

Glendale Sub Division

Greenwood, Miss.
(mailing address)

WELL LOCATION:

sec. 24 T 19 N R 1 E
1 miles SE of Greenwood
(distance) (direction) (nearest town)

WELL PURPOSE: SUB DIVISION
(home, irrigation, municipal, industrial)

WELL COMPLETION DATA:

- (1) diameter (inches) 6"
- (2) total depth (feet) 733
- (3) static water level (feet) 20 below above top of ground.
- (4) casing Steel 691 (material) (depth)
6" If telescope see back. (size)
- (5) screen 42 691 (length) (depth to top)
6" Stainless Steel (size) (material)
- (6) pump 20 250 (HP) (yield gpm)
Elec. (type power)
- (7) electric log No (yes or no)

(organization running log)

- (8) how well bottom plugged:
Back Pressure Valve

DRILLERS REMARKS:

description of formations encountered

from to

description of formations encountered	from	to
Clay	0	17
Muddy Sand	17	38
SAND	38	63
SAND + PEA GRAVEL	63	162
SHALE	162	231
SHALE + ROCK	231	243
SHALE + SAND	243	315
SHALE + ROCK	315	326
SHALE	326	405
ROCK	405	406
SHALE	406	415
SAND	415	460
SHALE	460	612
SANDY SHALE	612	655
WHITE SAND	655	746



CODED

JUN 17 1971

MISS. BOARD OF WATER COMMISSIONERS

If well telescopes please sketch and show depths.

GROUND LEVEL

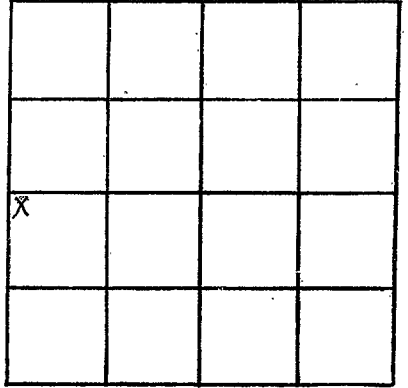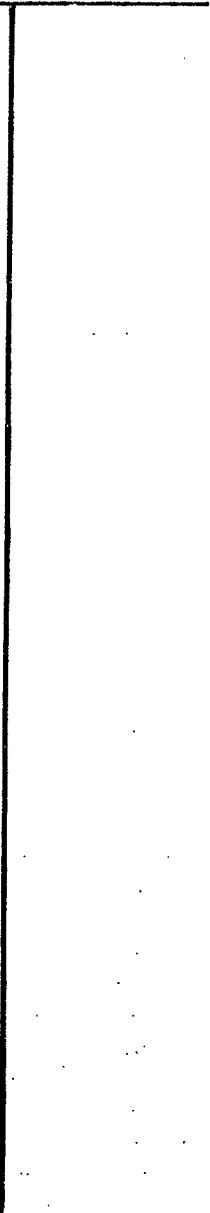

SECTION 24

Please indicate well location X.

ADDITIONAL INFORMATION

If more than one screen, show locations of each on sketch.