

LEFLORE MISSISSIPPI BOARD OF WATER COMMISSIONERS

L 174
3-23-64

3546
WATER WELL DRILLERS LOG

CODED

Date MARCH 23 19 64, Driller DELTA DRILLING Co County LEFLORE
(Name)

(1) Owner of Land: N. L. FREELAND
RTE 1
GREENWOOD, MISS.
(Name)
(Address)

(2) Location: 1/4, 1/4, Sec. 4 19th E T R
_____ miles _____ of _____
(distance) (direction) (Nearest Town)

(3) Topography: _____
(Hilly) (Flat) (Level)

(4) Purpose of Well: DOMESTIC
(Domestic Irrigation
Municipal, Industrial, Other)

Information upon completion of well:

(1) Diameter 4 inches.

(2) Total Depth 663 feet.

(3) Water Level FLOWS feet below top of ground.

(4) Cased to 643, Size 4" 68"
3" 334"
2" 282"

(5) Screen: Size 2", Length 20"

(6) Were any formations sealed against pollution?
_____ yes, _____ no.


If YES depth of formation _____

Why _____

Drillers Remarks: 11' GAP OF 2" IN
3" PIPE - WELL FLOWS
APPROX 50 G.P.M.

Description & Color of Materials Sand, Clay, Red Clay, Shell, etc.	Thick- ness Feet	Depth Feet
SAND	80	80
GRAVEL	42	122
SAND	10	132
GUMBO	38	170
SAND W/ROCK	18	188
SHALE W/ROCKS-	53	241
SAND W/ROCKS-	09	250
SHALE W/ROCK	66	316
SAND W/ROCKS-	109	425
SHALE	56	481
GUMBO	21	522
SAND	30	552
GUMBO	10	562
SHALE	22	584
SAND	79	663

CODED

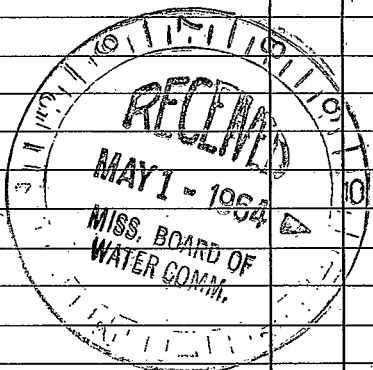

(Use Back Side)

Well No.

