

L 175
6-30-64

~~5584~~
WATER WELL DRILLERS LOG

CODED

Date: JUNE 30, 1964, Driller: DELTA DRILLING CO. County: LEFLORE

(Name)

(1) Owner of Land: TOM A. BARRENTINE
(Name)
RTE. 1, GREENWOOD, MISS
(Address)
(2) Location: 1/4, 14 19-1E
1/4, Sec. T R
_____ miles _____ of _____
(distance) (direction) (Nearest Town)
(3) Topography: _____
(Hilly) (Flat) (Level)
(4) Purpose of Well: DOMESTIC
(Domestic Irrigation
Municipal, Industrial, Other)


Description & Color of Materials Sand, Clay, Red Clay, Shell, etc.	Thick- ness Feet	Depth Feet
GUMBO	50	50
SAND	40	90
GRAVEL	44	134
GUMBO	30	164
GRAVEL	8	172
GUMBO	80	252
SHALE	30	282
GREEN SAND	48	330
SHALE	60	390
SAND	12	402
SHALE	41	443
SAND	40	483
GUMBO	40	523
SHALE	60	583
SAND	12	595
SHALE	53	648
SAND	114	762

Information upon completion of well:

(1) Diameter 4 inches.
(2) Total Depth 762 feet.
(3) Water Level FLOWS feet below top of ground.
(4) Cased to 742', Size 336'-2"
(5) Screen: Size 2", Length 20'
(6) Were any formations sealed against pollution?
_____ yes, _____ no.

If YES depth of formation _____
Why _____

Drillers Remarks: WELL FLOWS.

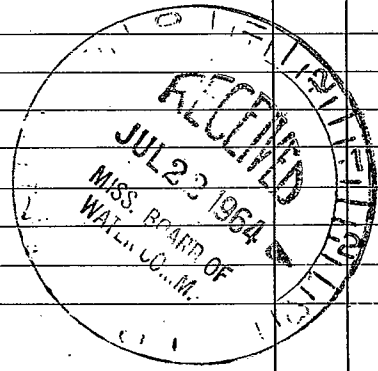

(Use Back Side)

Well No.

