

LeFLORE
L191
9-12-61

Coded

MISSISSIPPI
BOARD OF WATER COMMISSIONERS
 416 North State Street
 Jackson, Mississippi 39201


WATER WELL DRILLERS LOG

Sept 12 1961 Delta Drilling Co LeFlore
 date well completed firm name county well located

	description of formations encountered	from	to
LANDOWNER: <u>Gen. Young</u>			
<u>Cypress Lane Sub-D.</u>	<u>Top soil w/ sand</u>	<u>00</u>	<u>62</u>
<u>Greenwood Miss</u>	<u>Gravel</u>	<u>62</u>	<u>122</u>
<u>(mailing address)</u>	<u>Sand</u>	<u>122</u>	<u>144</u>
WELL LOCATION:	<u>Gumbo</u>	<u>144</u>	<u>200</u>
sec. <u>19 T 19 N</u> R. <u>2 E</u>	<u>GR. SAND w/ Rocks</u>	<u>200</u>	<u>245</u>
<u>4</u> miles <u>SE</u> of <u>Greenwood</u>	<u>Shale</u>	<u>245</u>	<u>285</u>
(distance) (direction) (nearest town)	<u>GR. SAND</u>	<u>285</u>	<u>348</u>
WELL PURPOSE: <u>Municipal</u>	<u>Shale</u>	<u>348</u>	<u>413</u>
(home, irrigation, municipal, industrial)	<u>GR SAND</u>	<u>413</u>	<u>425</u>
WELL COMPLETION DATA:	<u>Shale</u>	<u>425</u>	<u>455</u>
(1) diameter (inches) <u>4" x 2 1/2"</u>	<u>Sand</u>	<u>455</u>	<u>473</u>
(2) total depth (feet) <u>663'</u>	<u>Shale</u>	<u>473</u>	<u>525</u>
(3) static water level (feet) <u>Flows below</u>	<u>GR. sand</u>	<u>525</u>	<u>587</u>
top of ground. <u>60 GPM.</u>	<u>White sand</u>	<u>587</u>	<u>681</u>
(4) casing <u>steel</u> , <u>5# P.S.I.</u>	<u>Shale</u>	<u>681</u>	<u>700</u>
<u>400' - 4" (material)</u> , <u>(depth)</u>			
<u>163' - 2 1/2" (size)</u> if telescope see back.			
(5) screen <u>20'</u> , <u>643'</u>			
(length) (depth to top)			
<u>2 1/2'</u> , <u>S.S. Screen</u>			
(size) (material)			
(6) pump <u>3</u> , <u>75</u>			
(HP) (yield gpm)			
<u>Electric</u>			
(type power)			
(7) electric log <u>NO</u>			
(yes or no)			
(organization running log)			
(8) how well bottom plugged <u>B.P.</u>			
<u>1/2" PVC</u>			
DRILLERS REMARKS: <u>Flows @</u>			
<u>open discharges</u>			

If well telescopes please sketch and show depths.

GROUND LEVEL

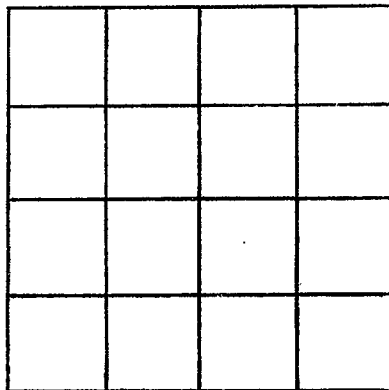

SECTION _____

Please indicate well location X.

ADDITIONAL INFORMATION

If more than one screen,
show locations of each on sketch.