

LEFLORE MISSISSIPPI BOARD OF WATER COMMISSIONERS

WATER WELL DRILLERS LOG

CODED

L 192
7-25-62

Coded

Date: JULY 25, 1962, Driller: DELTA DRILLING Co. County LEFLORE

(Name)

G. C. MONT JOY +
 (1) Owner of Land: SAM CERNIGLIA
FAIRHAVEN - (Name) SUB-DIVISION
GREENWOOD, MISS.
 (Address)

(2) Location: NE 1/4, NE 1/4, Sec. 20 T19N R2-E
 _____ miles _____ of _____
 (distance) (direction) (Nearest Town)

(3) Topography: _____
 (Hilly) (Flat) (Level)

(4) Purpose of Well: SUB-DIVISION
 (Domestic Irrigation
 Municipal, Industrial, Other)

Description & Color of Materials Sand, Clay, Red Clay, Shell, etc.	Thick- ness Feet	Depth Feet
TOP SOIL + SAND	73	73
GRAVEL	28	101
GUMBO	37	138
SAND	22	160
GUMBO	32	192
SHALE	60	252
SAND w/ ROCK	21	273
SHALE w/ ROCK	67	340
SAND w/ 8" ROCK	10	350
SHALE	30	380
GUMBO -	45	425
SHALE	23	448
SAND	32	480
SHALE	20	500
GUMBO	15	515
SAND	28	543
SHALE	35	578
SAND	15	593
GUMBO	5	598
SAND	29	627
GUMBO	15	642

Information upon completion of well:

(1) Diameter 4 inches.

(2) Total Depth 642 feet.

(3) Water Level WELL FLOWS feet below top of ground.

(4) Cased to 642', Size 4" 2 1/2


(5) Screen: Size 2 1/2, Length 20'
SS. 12 GA.

(6) Were any formations sealed against pollution?
 _____ yes, _____ no.

If YES depth of formation _____

Why _____

Drillers Remarks: 20'-LAP OF 2 1/2" PIPE IN 4" PIPE.
2 1/2" X 4" LEAD SEAL

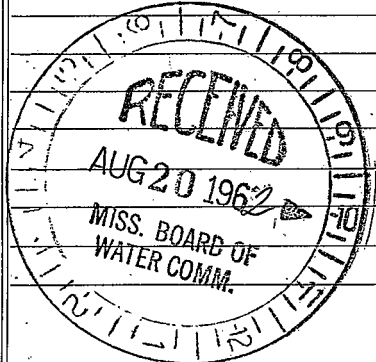

(Use Back Side)

Well No.

