

WATER WELL DRILLERS LOG

CODED

Date: OCT. 4, 1963, Drillers: DELTA DRILLING Co. County LEFLORE

(Name)

(1) Owner of Land: DR. TRACY J. MOSER

(Name)

GREENWOOD, MISS

(Address)

(2) Location: SW 1/4, NW 1/4, Sec. 17 T4N R2E

\_\_\_\_\_ miles \_\_\_\_\_ of \_\_\_\_\_  
(distance) (direction) (Nearest Town)

(3) Topography: \_\_\_\_\_  
(Hilly) (Flat) (Level)

(4) Purpose of Well: DOMESTIC  
(Domestic Irrigation  
Municipal, Industrial, Other)

Description & Color of Materials Sand, Clay, Red Clay, Shell, etc.	Thick- ness Feet	Depth Feet
SAND	63	63
GRAVEL	67	130
GUMBO W/ROCKS	53	183
SHALE W/ROCKS	43	226
SAND W/ROCKS	41	267
SHALE	21	288
SAND W/ROCKS	32	320
SHALE	10	330
SAND W/ROCKS	26	356
SHALE	44	400
GUMBO	30	430
SHALE	75	505
SAND	28	533
SHALE	52	585
WHITE SAND	20	605
SHALE	10	615
GREEN SAND	35	640
SHALE	30	670
WHITE SAND	44	714

Information upon completion of well:

(1) Diameter 4 inches.

(2) Total Depth 714 feet.

(3) Water Level WELL FLOWS feet below top of ground.

(4) Cased to 684, Size 3 3/8" - 4", Size 3 1/2" - 2"

(5) Screen: Size 2", Length 20'

(6) Were any formations sealed against pollution?

\_\_\_\_\_ yes, \_\_\_\_\_ no.


If YES depth of formation \_\_\_\_\_

Why \_\_\_\_\_

Drillers Remarks: 20' LAP OF 2"

IN 3" PIPE

714  
20'  
694

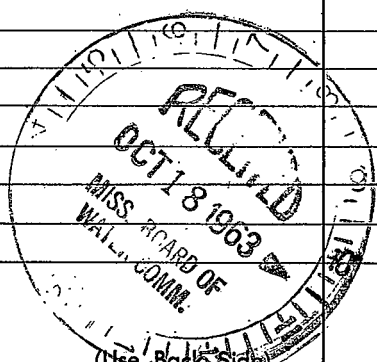

Well No.

