

LEFLORE
L 233
6-14-77

MISSISSIPPI
BOARD OF WATER COMMISSIONERS
 416 North State Street
 Jackson, Mississippi 39201

CODED

WATER WELL DRILLERS LOG

6-14-77 19 **BUTANE GAS CO. OF GREENWOOD** Leflore
 date well completed firm name county well located

LANDOWNER:	description of formations encountered	from	to
<u>Charles Moor</u>			
<u>Greenwood</u> (mailing address)	<u>Hard Sand</u>	<u>10</u>	<u>34</u>
WELL LOCATION:	<u>Clay</u>	<u>34</u>	<u>45</u>
sec. <u>23</u> T. <u>19</u> N R. <u>2</u> E	<u>SAND + Pea Gravel</u>	<u>45</u>	<u>60</u>
<u>1/2</u> miles <u>SW</u> of <u>FORT LORING</u>	<u>SAND + Gravel</u>	<u>60</u>	<u>95</u>
(distance) (direction) (nearest town)			
WELL PURPOSE: <u>IRR</u> (home, irrigation, municipal, industrial)			
WELL COMPLETION DATA:			
(1) diameter (inches) <u>16"</u>			
(2) total depth (feet) <u>95</u>			
(3) static water level (feet) <u>18</u> below above top of ground.			
(4) casing <u>Steel</u> , <u>55</u> , (material) (depth)			
<u>16"</u> (size) If telescope see back.			
(5) screen <u>40</u> , <u>55</u> (length) (depth to top)			
<u>16"</u> , <u>Steel</u> (size) (material)			
(6) pump <u>60</u> , <u>3000</u> (HP) (yield gpm)			
<u>Diesel</u> (type power)			
(7) electric log <u>no</u> (yes or no)			
(organization running log)			
(8) how well bottom plugged <u>Steel Plate</u>			
DRILLERS REMARKS:			


CODED

REGISTERED
PLUMBER
JUN 26 1977

MISS. BD. OF WATER COMM.

If well telescopes please sketch and show depths.

GROUND LEVEL

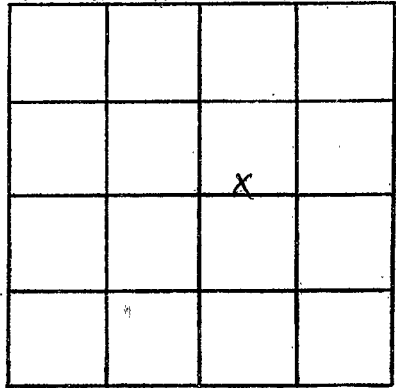

SECTION 2-3

Please indicate well location X.

ADDITIONAL INFORMATION

If more than one screen,
show locations of each on sketch.