

LEFLORE
L235
1/4/79

MISSISSIPPI
 BOARD OF WATER COMMISSIONERS
 416 North State Street
 Jackson, Mississippi 39201

CODED

WATER WELL DRILLERS LOG

Jan. 4 1979 Dyer Well & Irrigation Leflore
 date well completed firm name county well located

LANDOWNER: <u>Bob Hardeman</u>	description of formations encountered	from	to
<u>Cruzer, Miss.</u> (mailing address)	<u>Clay</u>	<u>0</u>	<u>14</u>
WELL LOCATION:	<u>FINE SAND</u>	<u>14</u>	<u>63</u>
sec. <u>28</u> T. <u>19</u> N R. <u>1</u> E	<u>SAND</u>	<u>63</u>	<u>80</u>
<u>3</u> miles <u>South</u> of <u>GREENWOOD</u> (distance) (direction) (nearest town)	<u>SAND & GRAVEL</u>	<u>80</u>	<u>106</u>
WELL PURPOSE: <u>IRRIGATION</u> (home, irrigation, municipal, industrial)	<u>FINE SAND</u>	<u>106</u>	<u>108</u>
WELL COMPLETION DATA:	<u>Bottom 108'</u>		
(1) diameter (inches) <u>16"</u>			
(2) total depth (feet) <u>108'</u>			
(3) static water level (feet) <u>16'</u> below above top of ground.			
(4) casing <u>STEEL</u> , <u>68'</u> (material) (depth)			
<u>16"</u> If telescope see back. (size)			
(5) screen <u>40'</u> , <u>68'</u> (length) (depth to top)			
<u>16"</u> , <u>Steel</u> (size) (material)			
(6) pump <u>60</u> <u>3,000</u> (HP) (yield gpm)			
<u>Diesel</u> (type power)			
(7) electric log <u>No</u> (yes or no)			
(organization running log)			
(8) how well bottom plugged <u>Plate</u>			
DRILLERS REMARKS:			

CODED


Miss. Board of Water Comm.

MAR 14 1979

RECEIVED

If well telescopes please sketch and show depths.

GROUND LEVEL

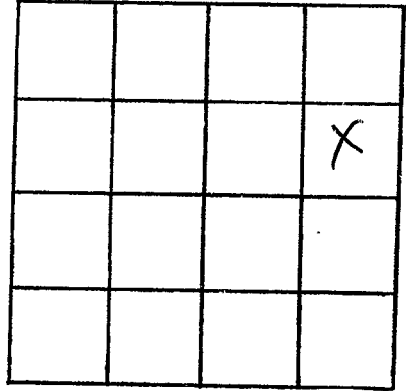

SECTION 28

Please indicate well location X.

ADDITIONAL INFORMATION

If more than one screen,
show locations of each on sketch.