

Leflore

MISSISSIPPI BOARD OF WATER COMMISSIONERS

L 79 236 pp 4/16

9-66

WATER WELL DRILLERS LOG

CODED

Date: SEPT 17, 1966, Driller: DELTA DRILLING Co County LEFLORE

(Name)

(1) Owner of Land: B. F. BARRENTINE

(Name)

GREENWOOD, MISS.

(Address)

(2) Location: NE 1/4, NW 1/4, Sec. 12 T19N R15E

GRENADA BLVD

miles

EXTENDED (direction)

GREENWOOD (Nearest Town)

(distance)

(direction)

(Nearest Town)

(3) Topography: FLAT

(Hilly)

(Flat)

(Level)

(4) Purpose of Well: DOMESTIC

(Domestic Irrigation

Municipal, Industrial, Other)

Description & Color of Materials
Sand, Clay, Red Clay, Shell, etc.

Thick-
ness
Feet

Depth
Feet

Gumbo	20	20
Sand	66	86
GRAVEL	48	134
Sand	60	194
gumbo CODED	22	216
green sand w/ROCK	49	265
Shale	10	275
green sand w/ROCK	72	347
green shale	43	390
green sand	14	404
green shale	14	418
Shale	22	440
gumbo	20	460
Shale	62	522
green sand	72	594
gumbo	17	611
Sand	69	680

Information upon completion of well:

(1) Diameter 4 inches.

(2) Total Depth 680 feet.

(3) Water Level FLOWS feet below top of ground.

(4) Cased to 660, Size 4" 100', 3" 300', 2" 284'

(5) Screen: Size 2", Length 20'

(6) Were any formations sealed against pollution?


yes, no.

If YES depth of formation 400'

Why

Drillers Remarks: 25' LAP OF 2"

IN 3" PIPE-

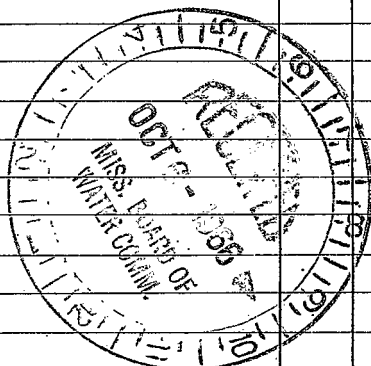

(Use Back Side)

Well No.

