

MISSISSIPPI DEPARTMENT OF NATURAL RESOURCES
Bureau of Land and Water Resources
 Southport Mall
 P.O. Box 10631
 Jackson, Mississippi 39209
WATER WELL DRILLERS LOG CODED

Loflore
 L 243
 12-11-80

12-11 1980 date well completed *Dyer* film name *Loflore* county well located

LANDOWNER: *Bob Nardeman*
Conger, MS.

description of formations encountered *11' well* from to

(mailing address)

0-15' Top Sandy Soil
1.5-11.3' Fine Sand

WELL LOCATION:
 sec *28* T *19* N R *10* S W
3 miles *S* of *Greenwood*
 (distance) (direction) (nearest town)


WELL PURPOSE:
 (home, irrigation, municipal, industrial)

WELL COMPLETION DATA:

- (1) diameter (inches) *16"*
- (2) total depth (feet) *113'*
- (3) static water level (feet) *20'* below above top of ground.
- (4) casing *Steel* *113'*
 (material) (depth)
16" if telescopic see back.
 (size)
- (5) screen *40'* *73'*
 (length) (depth to top)
16" *Steel*
 (size) (material)
- (6) pump *40* *2000*
 (HP) (yield gpm)
electric
 (type power)
- (7) electric log (yes or no)
 (organization running log)
- (8) how well bottom plugged *plate*

CODED

DRILLERS REMARKS:

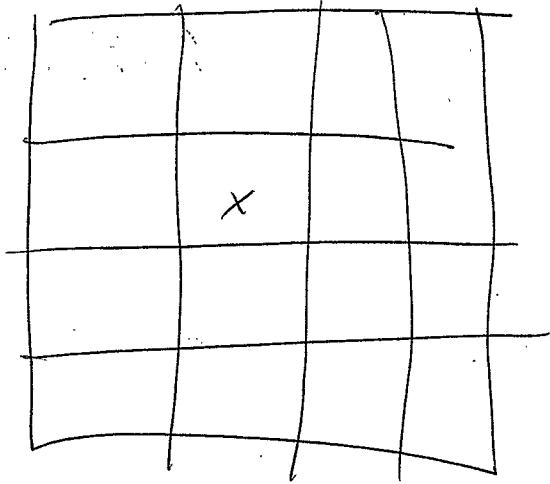

Sec 28