

Leflore

Bureau of Land and Water Resources

Southport Mall

P.O. Box 10631

Jackson, Mississippi 39209

WATER WELL DRILLERS LOG

3379

CODED

L 244
12-15-80

12/15 1980
date well completed

Dyer
firm name

Leflore
county well located

LANDOWNER:

FRENCH BEND

Yonell FRASER
Greenwood, MS
(mailing address)

WELL LOCATION:

sec. 31 T 19 N R 1 E
S W
6 miles S-W of Greenwood
(distance) (direction) (nearest town)

WELL PURPOSE:

(home, irrigation, municipal, industrial)

WELL COMPLETION DATA:

- (1) diameter (inches) 16"
- (2) total depth (feet) 101'
- (3) static water level (feet) 19' below above top of ground.
- (4) casing Steel 101'
(material) (depth)
16" if telescope sec. back.
(size)
- (5) screen 40' 61'
(length) (depth to top)
16" Steel
(size) (material)
- (6) pump 125 1200
(HP) (yield gpm)
Diesel
(type power)
- (7) electric log _____
(yes or no)
(organization running log)
- (8) how well bottom plugged plate


description of formations encountered

from


to

0-30 Sand top soil
30-101 Sand

CODED

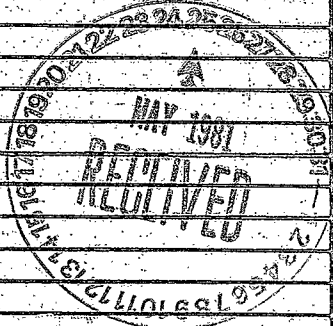

DRILLERS REMARKS:

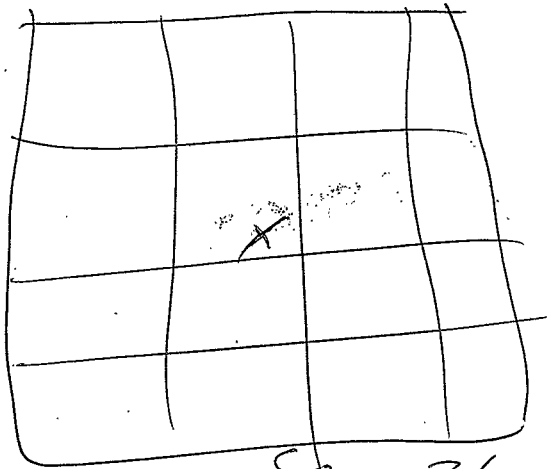

Sec 31
