

MISSISSIPPI DEPARTMENT OF NATURAL RESOURCES

Bureau of Land and Water Resources

Southport Mall

P.O. Box 10631

Jackson, Mississippi 39209

WATER WELL DRILLERS LOG

CODED

Leflore
VL 245
1-14-81

Jan 14 1981 Larry's Well & Pump Leflore
 date well completed firm name county/well located

LANDOWNER: <u>T. J. Corley</u>	description of formations encountered	from	to
<u>Greenwood ms</u> (mailing address)	<u>slay</u> <u>med sand</u> <u>stone sand</u>	<u>0</u> <u>20</u> <u>210</u>	<u>20</u> <u>40</u> <u>114'</u>
WELL LOCATION: sec. <u>36</u> T <u>19</u> N R <u>1</u> E <u>5</u> miles <u>S</u> of <u>Greenwood</u> (distance) (direction) (nearest town)			
WELL PURPOSE: (home, irrigation, municipal, industrial)			
WELL COMPLETION DATA:			
(1) diameter (inches) <u>16"</u>			
(2) total depth (feet) <u>114'</u>			
(3) static water level (feet) <u>6</u> <u>below</u> above top of ground.			
(4) casing <u>Steel</u> , <u>74'</u> (material) (depth) (size) If telescope see back.			
(5) screen <u>40'</u> , <u>74'</u> (length) (depth to top)			
<u>16"</u> , <u>Steel</u> (size) (material)			
(6) pump <u>60</u> , <u>3000</u> (HP) (yield gpm)			
(type power)			
(7) electric log <u>No</u> (yes or no)			
(organization running log)			
(8) how well bottom plugged <u>Steel Plate</u>			
DRILLERS REMARKS:			

CODED


DEPT. OF NATURAL RESOURCES
 BUREAU OF LAND & WATER RESOURCES

JUN 3 - 1981

RECEIVED

If well telescopes please sketch and show depths.

GROUND LEVEL

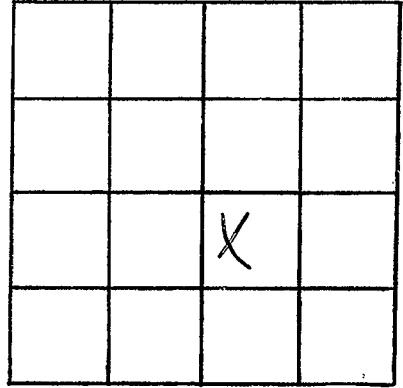

SECTION 36

Please indicate well location X.

ADDITIONAL INFORMATION

If more than one screen,
show locations of each on sketch.