

MISSISSIPPI DEPARTMENT OF NATURAL RESOURCES

Bureau of Land and Water Resources

Southport Mall

P.O. Box 10631

Jackson, Mississippi 39209

WATER WELL DRILLERS LOG

CODED

LEFLORE
L246
10/16/81

Oct. 16 19 81 Bruce Berryman - Leflore
date well completed firm name county well located
Greenwood, MS

LANDOWNER: Robert Kelley
Rt. 1. Box 221
Greenwood. MS 38930
(mailing address)

WELL LOCATION:
sec. 20 T. 19 N R. 1 E
5 miles E of Greenwood
(distance) (direction) (nearest town)

WELL PURPOSE: Home
(home, irrigation, municipal, industrial)

WELL COMPLETION DATA:
(1) diameter (inches) 4" x 2"
(2) total depth (feet) 681'
(3) static water level (feet) 15' below top of ground blk - 126'
(4) casing 2" galv. 535'
(material) (depth)
(size) if telescope see back.
(5) screen 20' 661'
(length) (depth to top)
2" .010 Stainless steel
(size) (material)
(6) pump 2 h.p. 60
(HP) (yield gpm)
Electric
(type power)
(7) electric log No
(yes or no)
(organization running log)
B.P.V.
(8) how well bottom plugged

description of formations encountered	from	to
Clay	0	20
Sand	20	60
Sand & Gravel	60	140
Clay	140	180
Shale & Rock	180	200
Green sand & Shale	200	220
Green sand	220	240
Sandy shale	240	300
Sandy shale & hard rock	300	320
Shale & Rocks	320	340
Sand	340	360
Shale	360	370
Brown sand	370	420
Shale	420	430
Sand	430	440
Shale	440	500
Fine sand	500	520
Shale	520	560
Fine sand	560	620
Shale	620	630
sand	630	680

CODED

DEPT. OF NATURAL RESOURCES
BUREAU OF LAND & WATER RESOURCES


APR 27 1982

RECEIVED

DRILLERS REMARKS:

If well telescopes please sketch and show depths.

GROUND LEVEL

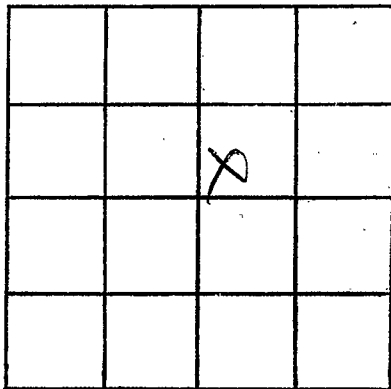

SECTION 20

Please indicate well location X.

ADDITIONAL INFORMATION

If more than one screen,
show locations of each on sketch.