

LEFLORE
L 249
2/15/83

MISSISSIPPI DEPARTMENT OF NATURAL RESOURCES
 Bureau of Land and Water Resources
 Southport Mall
 P.O. Box 10631
 Jackson, Mississippi 39209
WATER WELL DRILLERS LOG

CODED

Feb. 15 19 83 Bruce Berryman- Leflore
 date well completed firm name county well located
Greenwood.

LANDOWNER: Mr. Mike Bussey	description of formations encountered	from	to
Rt. 1. Box 227.	Clay	0	20
Greenwood. MS. 38930	Sx Sand	20	80
(mailing address)	Sand & gravel	80	140
WELL LOCATION:	Clay	140	160
sec. <u>17</u> T. <u>19</u> N R. <u>2</u> E	Sand	160	280
35 miles <u>East</u> of <u>G'wood</u>	Shale & rock	280	320
(distance) (direction) (nearest town)	Green sand	320	380
WELL PURPOSE: Home	Shale	380	500
(home, irrigation, municipal, industrial)	Sand	500	510
WELL COMPLETION DATA:	Shale	510	520
(1) diameter (inches) <u>2" x 4"</u>	Sand	520	550
(2) total depth (feet) <u>629 ft.</u>	Shale	550	560
(3) static water level (feet) <u>10' below</u>	Sand	560	630
top of ground <u>blk. - 126'</u>			
(4) casing <u>2" galv.</u> - <u>483'</u>			
(material) (depth)			
<u> </u> if telescope see back.			
(size)			
(5) screen <u>20'</u> / <u>609'</u>			
(length) (depth to top)			
2" .010 gauge stainless			
(size) (material) <u>steel</u>			
(6) pump <u>h.p.</u> / <u>18</u>			
(HP) (yield gpm)			
<u>Electric</u>			
(type power)			
(7) electric log <u>NO</u>			
(yes or no)			
<u> </u>			
(organization running log)			
(8) how well bottom plugged <u>B.P.V.</u>			

CODED

DEPT. OF NATURAL RESOURCES
 BUREAU OF LAND & WATER RESOURCES


MAY 12 1983

RECEIVED

DRILLERS REMARKS:

If well telescopes please sketch and show depths.

GROUND LEVEL

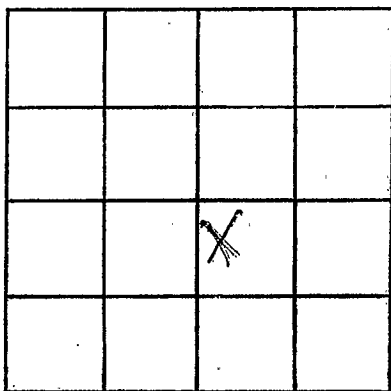

SECTION 17

Please indicate well location X.

ADDITIONAL INFORMATION

If more than one screen,
show locations of each on sketch.