

L252 E06#112
LEFLORE
1-28-84

MISSISSIPPI
BOARD OF WATER COMMISSIONERS
416 North State Street
Jackson, Mississippi 39201

CODED

WATER WELL DRILLERS LOG

Jan. 23 1984 Layne-Central Co Leflore
date well completed firm name county well located

LANDOWNER: City of Greenwood, Greenwood Mississippi
(mailing address)

WELL LOCATION:
sec. 15 T. 19 S. R. 1 W.
(distance) miles (direction) of (nearest town)

WELL PURPOSE: municipality
(home, irrigation, municipal industrial)

WELL COMPLETION DATA:

- (1) diameter (inches) 16"
- (2) total depth (feet) 842'
- (3) static water level (feet) 20' below top of ground.
- (4) casing steel, 770' (material) (depth).
16" (size) If telescope see back.
- (5) screen 60', 770' (length) (depth to top).
8" (size) stainless steel (material).
- (6) pump 75 460 (HP) (yield gpm).
electric (type power)
- (7) electric log yes (yes or no).
MS Geo. Surrency (organization running log)
- (8) how well bottom plugged stainless steel

description of formations encountered	from	to
gumbo	0	5
clay	5	37
sand + pea gravel	37	87
gravel + loose sand	87	232
hard clay	232	283
rock	283	285
clay	285	363
rock	363	364
hard shale. CODED	364	454
clay + rock str.	454	463
rock	463	466
hard clay	466	470
rock	470	474
hard shale	474	624
sandy shale	624	630
hard shale	630	722
shale + sand str.	722	818
sand	818	906
shale	906	909
rock; steel in rock	909	915

DEPT. OF NATURAL RESOURCES
BUREAU OF LAND & WATER RESOURCES


JUL 23 1984

RECEIVED

DRILLERS REMARKS:

If well telescopes please sketch and show depths.

GROUND LEVEL

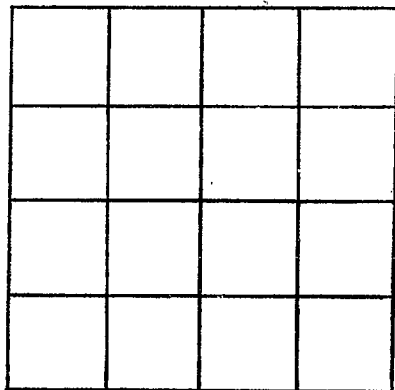

SECTION _____

Please indicate well location X.

ADDITIONAL INFORMATION

If more than one screen,
show locations of each on sketch.