

MISSISSIPPI DEPARTMENT OF NATURAL RESOURCES

Bureau of Land and Water Resources

Southport Mall

P.O. Box 10631

Jackson, Mississippi 39209

WATER WELL DRILLERS LOG

CODED

LEFLORE
L 254
6-1-84

6/1/84 19 Dyer Well firm name Leflore county well located


LANDOWNER:	description of formations encountered	from	to
<u>Greenwood Community Club.</u>	<u>Clay</u>	<u>0</u>	<u>28</u>
<u>GREENWOOD, Miss.</u> (mailing address)	<u>Fine Sand</u>	<u>28</u>	<u>36</u>
	<u>Sand & Gravel</u>	<u>56</u>	<u>103</u>
WELL LOCATION: sec. <u>14</u> T. <u>12</u> N. R. <u>1</u> E. S. <u>5</u> <u>2</u> miles <u>East</u> of <u>Greenwood</u> (distance) (direction) (nearest town)			
WELL PURPOSE: (home, irrigation, municipal, industrial)			
WELL COMPLETION DATA: (1) diameter (inches) <u>12</u> (2) total depth (feet) <u>103'</u> (3) static water level (feet) <u>31'</u> below above top of ground. (4) casing <u>STEEL</u> , <u>63'</u> (material) (depth) <u>12</u> if telescope see back. (size) (5) screen <u>4ft</u> , <u>63'</u> (length) (depth to top) <u>12"</u> , <u>STEEL</u> (size) (material) (6) pump <u>30</u> <u>1200</u> (HP) (yield gpm) <u>elec</u> (type power) (7) electric log <u>No</u> (yes or no) (organization running log) (8) how well bottom plugged <u>STEEL PLATE</u>			
DRILLERS REMARKS:			

CODED

DEPT. OF NATURAL RESOURCES
BUREAU OF LAND & WATER RESOURCES
JUL - 2 1984
RECEIVED

If well telescopes please sketch and show depths.

GROUND LEVEL

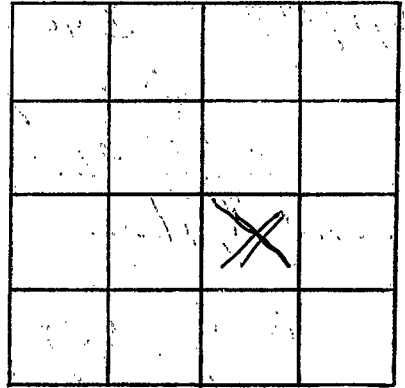

SECTION 14

Please indicate well location X.

ADDITIONAL INFORMATION

If more than one screen,
show locations of each on sketch.