

MISSISSIPPI DEPARTMENT OF NATURAL RESOURCES
 Bureau of Land and Water Resources
 Southport Mall
 P.O. Box 10631
 Jackson, Mississippi 39209
WATER WELL DRILLERS LOG

CODED

LEFLORE
255
5-26-84

5/26/84 19 Dyer Well LEFLORE
 date well completed firm name county well located

LANDOWNER: Gordon Cox & Trainers Ins. Co
Memphis, Tenn.
 (mailing address)

description of formations encountered	from	to
<u>Clay</u>	<u>0</u>	<u>28</u>
<u>fine sand</u>	<u>28</u>	<u>35</u>
<u>Sand + Gravel</u>	<u>35</u>	<u>90</u>

WELL LOCATION:
 sec. 27 T 19 N R. 1 E
2 miles N of Sidon
 (distance) (direction) (nearest town)

WELL PURPOSE:
 (home, irrigation, municipal, industrial)

WELL COMPLETION DATA:


- (1) diameter (inches) 16"
- (2) total depth (feet) 90'
- (3) static water level (feet) 24' below top of ground.
- (4) casing 50' (material) STEEL (depth)
16" (size) if telescope see back.
- (5) screen 50' (length) (depth to top)
16" (size) STEEL (material)
- (6) pump 100 (HP) 1700 (yield gpm)
DIES (type power)
- (7) electric log NO (yes or no)
 (organization running log)
- (8) how well bottom plugged STEEL PLATE

DRILLERS REMARKS:

SEPT. OF NATURAL RESOURCES
 BUREAU OF LAND & WATER RESOURCES
 JUL - 2 1984
RECEIVED

If well telescopes please sketch and show depths.

GROUND LEVEL

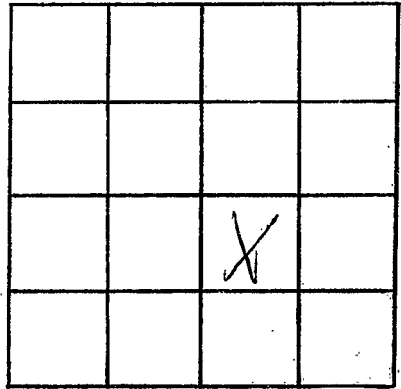

SECTION 27

Please indicate well location X.

ADDITIONAL INFORMATION

If more than one screen,
show locations of each on sketch.