

MISSISSIPPI DEPARTMENT OF NATURAL RESOURCES

Bureau of Land and Water Resources

Southport Mall

P.O. Box 10631

Jackson, Mississippi 39209

CODED

33 31 39
90 08 59

126

WATER WELL DRILLERS LOG

LEFLORE
L258
1-20-86

Jan. 20

19 86

Bruce Berryman

Leflore

date well completed

firm name
Greenwood. MS

county well located

LANDOWNER: Tom Gohagan
704 Grenada Blvd.
Greenwood. MS. 38930.
(mailing address)

WELL LOCATION:
sec. 12 T. 19 N R. 1 E
In Greenwood. W
_____ miles _____ of _____
(distance) (direction) (nearest town)

WELL PURPOSE: Home
(home, irrigation, municipal, industrial)

WELL COMPLETION DATA:

(1) diameter (inches) 4" x 2"
(2) total depth (feet) 561'
(3) static water level (feet) 15' below top of ground. 4" blk. - 126'
(4) casing 2" gal. - 425'
(material) (depth)
_____ if telescope see back.
(size)
(5) screen 10' , 551'
(length) (depth to top)
2" .010 ga. Stainless steel
(size) (material)
(6) pump 3/4 10
(HP) (yield gpm)
Electric
(type power)
(7) electric log Yes
(yes or no)
Ms. Bureau of Geology.
(organization running log)
(8) how well bottom plugged B.P.V.

description of formations encountered	from	to
Clay	0	40
Sand & Gravel	40	140
Clay	140	160
Sand	160	190
Shale	190	230
Sand	230	240
Clay	240	250
Sand	250	270
Clay	270	310
Sand	310	330
Shale	330	400
Sand	400	410
Sand str. shale	410	430
Shale	430	550
Sand	550	560
Sand & shale	560	580


RECEIVED
FEB 20 1986

Department of Natural Resources
Bureau of Land & Water Resources

DRILLERS REMARKS:

If well telescopes please sketch and show depths.

GROUND LEVEL

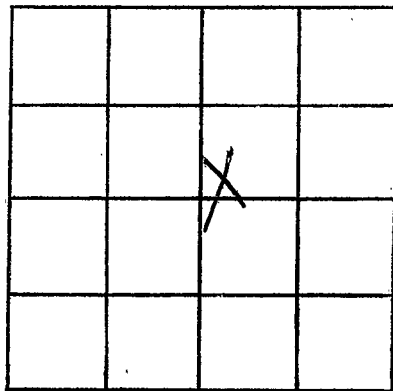

SECTION 12

Please indicate well location X.

ADDITIONAL INFORMATION

If more than one screen,
show locations of each on sketch.