

CODE D2

MISSISSIPPI DEPARTMENT OF NATURAL RESOURCES

Bureau of Land and Water Resources

COUNTY WELL LOCATED  
LeFlore

WELL NUMBER L 263 CODED

DATE WELL COMPLETED  
7-20-88

PERMIT NUMBER

NAME OF DRILLING FIRM  
J & B LITHIATION

P.O. Box 10631  
Jackson, Mississippi 39209  
WATER WELL DRILLERS LOG

NAME & MAILING ADDRESS OF LANDOWNER  
Mike Bossey  
RT. 5, Box 25  
Greenwood, Miss 38930

WELL LOCATION: SEC 17 TOWNSHIP 19 RANGE N 2 E

DISTANCE 5 Miles DIRECTION E of NEAREST TOWN Greenwood

OTHER LANDMARK

WELL PURPOSE: Home, Irrigation, Municipal, Industrial, Fish Pond, etc.

PUMP DATA

PUMP TYPE (Circle One):  
Submersible, Turbine, Jet, Flowing Well,  
Other (Describe)

POWER TYPE (Circle One):  
Electric, Tractor, Diesel, Gasoline, Butane,  
Other (Describe)

Pump Capacity (GPM) 1500 No. of Stages 2 Setting Depth 50 FT.

PUMP TEST

Well yielded 1500 GPM with  
a drawdown of 21 ft.  
after \_\_\_\_\_ hours of pumping

WELL DATA

Well Depth 185 Casing Diameter (In.) 12 Casing Length (Ft.) 75

Type of Casing Steel Hole Depth 115 Depth to Static Water Level 19

TYPE OF COMPLETION: (Circle One or More):  
Gravel Packed, Underreamed, Telescoped,  
Natural Development, Open Hole, Other

Top of Lap Pipe or Reduction in Casing

FEET IF TELESCOPED OR MORE THAN ONE SCREEN: USE BACK PAGE

LOG DATA

TYPE OF LOG RUN (Circle One):  
No Log Run, Electric, Gamma Ray, Density, Sonic, Neutron,  
Other (Describe)

Name of Organization Running Log

SCREEN DATA

Diameter - Inches 12 Length - Feet 40 Slot Size - Inches .030

Screen Type Steel Depth to Bottom - Feet 115

GEOLOGIC DATA (Office Use Only)

Surface Elev.	Geologic Unit	Unit Thickness	Depth to Top
Subs. SWL	Date	Analysis	Aquifer Test

Driller's Remarks


**RECEIVED**

DESCRIPTION OF FORMATIONS ENCOUNTERED	FROM	TO	FORMATIONS (Continued)	FROM	TO
<u>CLAY</u>	<u>0</u>	<u>11</u>	<b>SEP 14 1988</b>  Department of Natural Resources Bureau of Land & Water Resources		
<u>Fine Sand</u>	<u>11</u>	<u>28</u>			
<u>SAND</u>	<u>25</u>	<u>46</u>			
<u>SAND &amp; GRAVEL</u>	<u>46</u>	<u>115</u>			

IF MORE SPACE IS NEEDED, USE BACK

If well telescopes please sketch and show depths.

GROUND LEVEL

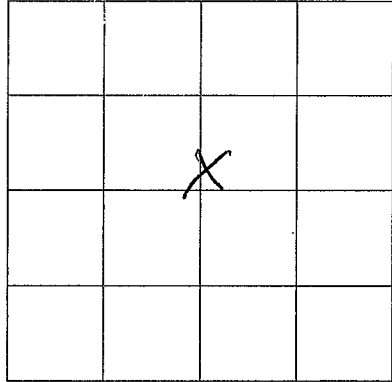

SECTION 17

Please indicate well location X.

ADDITIONAL INFORMATION

If more than one screen,  
show location of each on sketch.