

MISSISSIPPI DEPARTMENT OF NATURAL RESOURCES

Bureau of Land and Water Resources

COUNTY WELL LOCATED <i>LeFlore</i>
WELL NUMBER <i>L 265</i>
DATE WELL COMPLETED <i>4-8-89</i>

149A

PERMIT NUMBER
NAME OF DRILLING FIRM <i>J & K HARRIS</i>

CODED

P.O. Box 10631
Jackson, Mississippi 39209
WATER WELL DRILLERS LOG

NAME & MAILING ADDRESS OF LANDOWNER
Fred Grossman
Greenwood, ms 38930

WELL LOCATION: SEC *29* TOWNSHIP *19 N* RANGE *1 E*

DISTANCE *3* Miles DIRECTION *SE* of NEAREST TOWN *Greenwood*

OTHER LANDMARK

WELL PURPOSE: Home, Irrigation, Municipal, Industrial, Fish Pond, etc.

PUMP DATA

PUMP TYPE (Circle One):
Submersible, Turbine, Jet, Flowing Well,
Other (Describe)

POWER TYPE (Circle One):
Electric, Tractor, Diesel, Gasoline, Butane,
Other (Describe)

Pump Capacity (GPM) <i>1800</i>	No. of Stages <i>4</i>	Setting Depth <i>50</i> FT.
------------------------------------	---------------------------	--------------------------------

PUMP TEST

Well yielded *1800* GPM with
a drawdown of _____ ft.
after _____ hours of pumping

WELL DATA

Well Depth <i>117</i>	Casing Diameter (In.) <i>16</i>	Casing Length (Ft.) <i>80</i>
Type of Casing <i>Steel</i>	Hole Depth <i>117</i>	Depth to Static Water Level <i>19</i>

TYPE OF COMPLETION: (Circle One or More):
Gravel Packed, Underreamed, Telescoped,
Natural Development, Open Hole, Other

Top of Lap Pipe or Reduction in Casing
FEET IF TELESCOPED OR MORE THAN ONE SCREEN: USE BACK PAGE

LOG DATA

TYPE OF LOG RUN (Circle One):
Electric, Gamma Ray, Density, Sonic, No Log Run, Neutron,
Other (Describe)

Name of Organization Running Log

SCREEN DATA

Diameter - Inches <i>16</i>	Length - Feet <i>40</i>	Slot Size - Inches <i>.030</i>
Screen Type <i>Steel</i>	Depth to Bottom - Feet <i>117</i>	

GEOLOGIC DATA (Office Use Only)

Surface Elev.	Geologic Unit	Unit Thickness	Depth to Top
Subs. SWL	Date	Analysis	Aquifer Test

Driller's Remarks

RECEIVED

DESCRIPTION OF FORMATIONS ENCOUNTERED	FROM	TO	FORMATIONS (Continued)	FROM
<i>CLAY</i>	<i>0</i>	<i>27</i>		
<i>SAND</i>	<i>27</i>	<i>48</i>		
<i>SAND & GRAVEL</i>	<i>48</i>	<i>117</i>		


MAR 18 1989

*Department of Natural Resources
Bureau of Land & Water Resources*

IF MORE SPACE IS NEEDED, USE BACK

If well telescopes please
sketch and show depths.

GROUND LEVEL

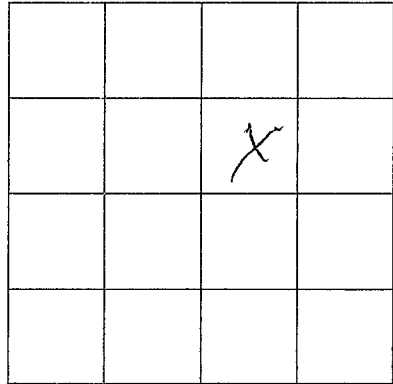

SECTION 29

Please indicate well location X.

ADDITIONAL INFORMATION

If more than one screen,
show location of each on sketch.