

L-278

33-30-32 90-12-49

MISSISSIPPI DEPARTMENT OF ENVIRONMENTAL QUALITY

Office of Land and Water Resources

P. O. Box 10631
Jackson, MS 39289-0631
WATER WELL DRILLERS LOG

COUNTY, WELL LOCATED
Leflore

WELL NUMBER **1** CODED

DATE WELL COMPLETED
6/20/02

PERMIT NUMBER

NAME OF DRILLING FIRM
ALFord Irrig.

NAME & MAILING ADDRESS OF LANDOWNER
Michael Bussey
27274 CR 141
ITTA BENA Miss. 38941

WELL LOCATION: SEC TOWNSHIP RANGE
NW 17 T19 S1 R1 E

DISTANCE DIRECTION NEAREST TOWN
4 Miles **W** of **Dyerswood**

OTHER LANDMARK

WELL PURPOSE: Home Irrigation Municipal, Industrial, Fish Pond, etc.

PUMP DATA

PUMP TYPE (Circle One):
Submersible, Turbine, Jet, Flowing Well, Other (Describe)

POWER TYPE (Circle One):
Electric, Tractor, Diesel, Gasoline, Butane, Other (Describe) H/P **60**

Pump Capacity (GPM) No. of Stages Setting Depth
300 **1** **60** FT.

PUMP TEST
Well yielded _____ GPM with a drawdown of _____ ft. after _____ hours of pumping

WELL DATA

Well Depth 120	Casing Diameter (in.) 16	Casing Length (ft.) 90
Type of Casing PVC	Hole Depth 120	Depth to Static Water Level

TYPE OF COMPLETION: (Circle One or More):
Gravel Packed Underreamed, Telescoped, Natural Development, Open Hole, Other (Describe)

WELL GROUTED TO A DEPTH OF _____ FEET
Type Grout (circle one): Cement, Bentonite, or Mix

LOG DATA

TYPE OF LOG RUN (Circle One): No Log Run
Electric, Gamma Ray, Density, Sonic, Neutron, Other (Describe)

Name of Organization Running Log

SCREEN DATA

Diameter - Inches 16	Length - Feet 40	Slot Size - Inches 32
Screen Type PVC	Depth to Bottom - Feet 120	

GEOLOGIC DATA (Office Use Only)

Surface Elev.	Geologic Unit	Unit Thickness	Depth to Top
Subs. SWL	Date	Analysis	Aquifer Test

Driller's Remarks


DESCRIPTION OF FORMATIONS ENCOUNTERED	FROM	TO	FORMATIONS (Continued)	FROM	TO
CLAY	0	41			
FINE SAND	41	58			
SAND GRAVEL	58	120			

RECEIVED
FEB 18 2003
BY: OLWR

IF MORE SPACE IS NEEDED, USE BACK

If well telescopes please sketch and show depths.

GROUND LEVEL

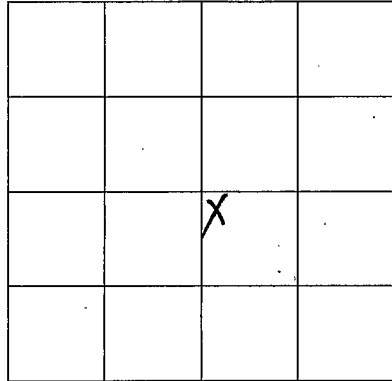

SECTION 17
Please indicate well location X.

ADDITIONAL INFORMATION

If more than one screen,
show location of each on sketch.